

PANOLA
E 21
4-20-73

MISSISSIPPI
BOARD OF WATER COMMISSIONERS
416 North State Street
Jackson, Mississippi 39201

CODED

WATER WELL DRILLERS LOG

4-20

1973 James R. Lipe

Panola

date well completed


firm name

county well located

LANDOWNER:	description of formations encountered	from	to
Ann Groose COMO MISS. (mailing address)	Top soil Clay Gravel " " " "	0 20 40 60 80	20 40 60 80 100
WELL LOCATION: sec. 24 T 7 N R 9 E 6 miles West of COMO (distance) (direction) (nearest town)	" " Sand " "	80 100 120	100 120 143
WELL PURPOSE: Home (home, irrigation, municipal, industrial)	CODED		
WELL COMPLETION DATA:			
(1) diameter (inches) 4			
(2) total depth (feet) 143			
(3) static water level (feet) 40 below top of ground.			
(4) casing PVC 133 (material) (depth)			
4 (size) if telescope see back.			
(5) screen 10 133 (length) (depth to top)			
4 PVC (size) (material)			
(6) pump 3/4 10 (HP) (yield gpm)			
Elec. (type power)			
(7) electric log NO (yes or no)			
NO (organization running log)			
(8) how well bottom plugged PVC			
plug			
DRILLERS REMARKS:			

If well telescopes please sketch and show depths.

GROUND LEVEL

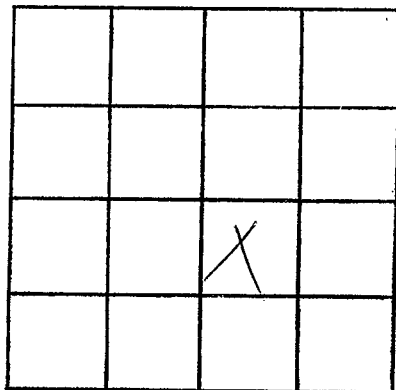

SECTION

24

Please indicate well location X.

ADDITIONAL INFORMATION

If more than one screen,
show locations of each on sketch.