

PANOLA
E 23
2-12-74

MISSISSIPPI
BOARD OF WATER COMMISSIONERS
416 North State Street
Jackson, Mississippi 39201

CODED

WATER WELL DRILLERS LOG

2-12 1974 LIPE well Co. Panola
date well completed firm name county well located

LANDOWNER:
Mable Jancy
Crenshaw Miss.
(mailing address)

description of formations encountered	from	to
Top soil	0	20
Sand	20	104

WELL LOCATION:
sec 2 T 2 N R 9 E
1 miles South of Crenshaw
(distance) (direction) (nearest town)

WELL PURPOSE:
(home) Irrigation, municipal, industrial

- WELL COMPLETION DATA:
- (1) diameter (inches) 4
 - (2) total depth (feet) 104
 - (3) static water level (feet) 10 below top of ground.
 - (4) casing PVC, 94 (material), (depth), 4 (size) if telescope see back.
 - (5) screen 10, 94 (length), (depth to top), 4 (size), PVC (material)
 - (6) pump 3/4 (HP), 10 (yield gpm), elec. (type power)
 - (7) electric log no (yes or no), no (organization running log)
 - (8) how well bottom plugged PVC Plug


CODED

RECEIVED
MAR 5 1974

DRILLERS REMARKS:

If well telescopes please sketch and show depths.

GROUND LEVEL

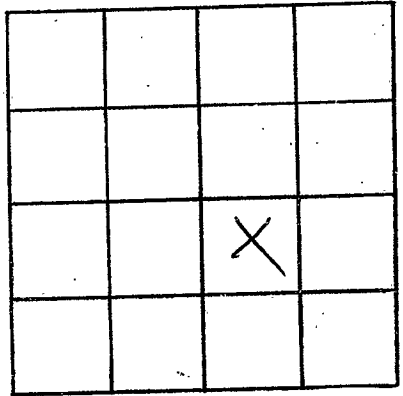

SECTION 2

Please indicate well location X.

ADDITIONAL INFORMATION

If more than one screen, show locations of each on sketch.