

PANOLA
E25
9-16-74

MISSISSIPPI
BOARD OF WATER COMMISSIONERS
416 North State Street
Jackson, Mississippi 39201 **CODED**

WATER WELL DRILLERS LOG

Sept. 16 1974 Beh. Smith & Son Panola
date well completed firm name county well located

LANDOWNER: W.C. Carpenter
302 Lafayette
Senatobia, Ms.
(mailing address)

description of formations encountered	from	to
<u>Top Soil + Red Sand</u>	<u>0</u>	<u>50</u>
<u>Yellow Sand</u>	<u>50</u>	<u>90</u>
<u>White Clay</u>	<u>90</u>	<u>100</u>
<u>Blue Clay</u>	<u>100</u>	<u>190</u>
<u>Sand</u>	<u>190</u>	<u>248</u>

WELL LOCATION:
sec. 12 T 7 N R 9 E
4 miles SW of Longtown
(distance) (direction) (nearest town)

WELL PURPOSE:
(home, irrigation, municipal, industrial)


- WELL COMPLETION DATA:
- (1) diameter (inches) 4
 - (2) total depth (feet) 248
 - (3) static water level (feet) 135 below top of ground.
 - (4) casing Plastic, 248
(material) (depth)
(size) if telescope see back.
 - (5) screen 4", 20'
(length) (depth to top)
4", Plastic
(size) (material)
 - (6) pump 1/2, 10
(HP) (yield gpm)
electric
(type power)
 - (7) electric log No
(yes or no)
(organization running log)
 - (8) how well bottom plugged _____

DRILLERS REMARKS:

RECEIVED
SEP 22 1974

If well telescopes please sketch and show depths.

GROUND LEVEL

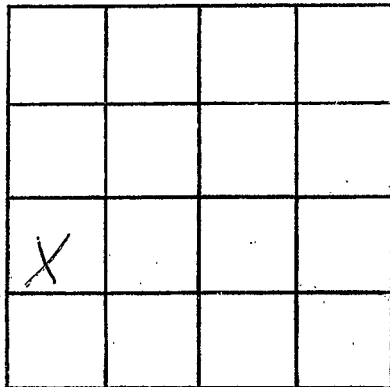

SECTION 12

Please indicate well location X.

ADDITIONAL INFORMATION

If more than one screen,
show locations of each on sketch.