

PANOLA
 EZZ
 8-25-74

MISSISSIPPI
 BOARD OF WATER COMMISSIONERS
 416 North State Street
 Jackson, Mississippi 39201


CODED

WATER WELL DRILLERS LOG

8-25-74 date well completed W.A. Mason firm name Panola county well located

LANDOWNER:	description of formations encountered	from	to
James Cowan	Clay dirt	80	10
RFD, Conshauk Miss (mailing address)	gravel	10	14
WELL LOCATION:	Red Sand	14	60
sec. 15 T 7 N R 9 E 1 1/2 miles SE of Conshauk	blue clay	60	100
(distance) (direction) (nearest town)	white sand	100	155
WELL PURPOSE: (home, irrigation, municipal, industrial)			
WELL COMPLETION DATA:			
(1) diameter (inches) 4"			
(2) total depth (feet) 155'			
(3) static water level (feet) 90' below top of ground.			
(4) casing Plaster 145' (material) (depth)			
4" if telescope see back. (size)			
(5) screen 10' 145' (length) (depth to top)			
4" Plaster (size) (material)			
(6) pump 3/4 10 (HP) (yield gpm)			
electric (type power)			
(7) electric log No (yes or no)			
(organization running log)			
(8) how well bottom plugged Cap			
DRILLERS REMARKS:			

CODED

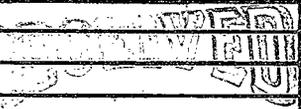


DEC 27 1974

MISS. BD. OF WATER COMMISSIONERS

If well telescopes please sketch and show depths.

GROUND LEVEL

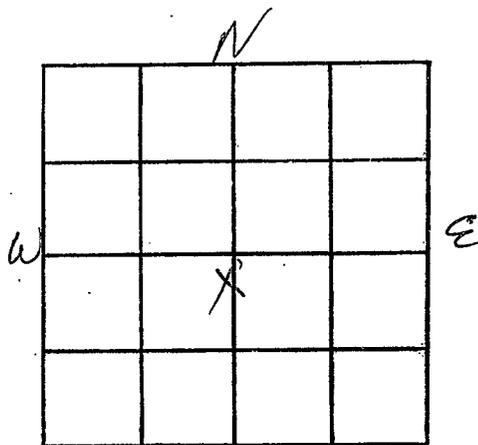

SECTION 15

Please indicate well location X.

ADDITIONAL INFORMATION

If more than one screen, show locations of each on sketch.