

PANOLA  
E27  
42-75

MISSISSIPPI  
BOARD OF WATER COMMISSIONERS  
416 North State Street  
Jackson, Mississippi 39201

WATER WELL DRILLERS LOG

CODED

4-2-1975 date well completed  
B. Shabo Well Co. firm name  
Panola county well located

LANDOWNER: Nobel Bell  
PO Box 16,  
Sarah, Miss.  
(mailing address)

WELL LOCATION:  
sec 2 T 7 N R 9 E  
1 miles SE of Longtown  
(distance) (direction) (nearest town)

WELL PURPOSE: Home  
(home, irrigation, municipal, industrial)

WELL COMPLETION DATA:

(1) diameter (inches) 4 1/2

(2) total depth (feet) 320

(3) static water level (feet) 150 below top of ground.

(4) casing Plastic, 320,  
(material) (depth)  
(size) If telescope see back.

(5) screen 7 ft, 313,  
(length) (depth to top)  
4 in. Inside gravel  
(size) (material)

(6) pump 1/2 10  
(HP) (yield gpm)  
Electric 230  
(type power)

(7) electric log no  
(yes or no)

(organization running log)

(8) how well bottom plugged Cap


description of formations encountered	from	to
<u>Red clay</u>	<u>0</u>	<u>15</u>
<u>Gravel</u>	<u>15</u>	<u>30</u>
<u>Red sand + gravel</u>	<u>30</u>	<u>60</u>
<u>Gravel</u>	<u>60</u>	<u>75</u>
<u>Gravel + black clay</u>	<u>75</u>	<u>90</u>
<u>Black clay</u>	<u>90</u>	<u>195</u>
<u>Black clay + white sand</u>	<u>195</u>	<u>240</u>
<u>white sand</u>	<u>240</u>	<u>285</u>
<u>white sand + black clay</u>	<u>270</u>	<u>285</u>
<u>white sand</u>	<u>285</u>	<u>320</u>

RECEIVED  
MAY 23 1975

DRILLERS REMARKS:

If well telescopes please sketch and show depths.

GROUND LEVEL

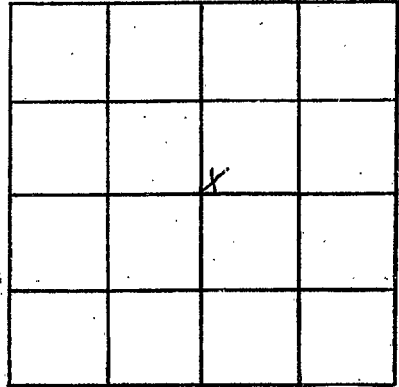

SECTION     

Please indicate well location X.

ADDITIONAL INFORMATION

If more than one screen, show locations of each on sketch.