

County: Panola
 Permit #: GW-47609V
 Driller: Joel Jumper
 Date drilling completed: 9-10-13

State Well Report
Part I - Driller's Log
 Mississippi Department of Environmental Quality
 Office of Land and Water Resources
 P.O. Box 2309
 Jackson, MS 39225
 (601)961- 5210
 (601)961- 5228 (fax)

For Office Use Only:
 Aquifer: _____
 Well #: E60
 L. S. Elevation: _____
 E-log #: _____

State Law requires that this report be prepared by the license holder responsible for the work and filed with the Department at the above address within 30 days of completion of drilling of the well or borehole.

Information on Well Owner (Landowner if borehole is not for a water well)	Well or Borehole Location
Owner Name: <u>Buckeye Farms</u>	Latitude: <u>34° 25' 43"</u> Longitude: <u>90° 10' 10"</u>
Mailing Address: <u>Po Box 3066</u>	Method of Lat/Long (circle one): Conventional Survey, USGS quad, <u>Hand-held GPS</u> , Survey-grade GPS <u>9W</u>
<u>Lemo</u> <u>Ms</u> <u>35010</u>	<u>NW</u> 1/4 <u>SE</u> 1/4 Sec <u>32</u> Twn <u>07S</u> Rng <u>01E</u>
City State Zip Code	Distance Direction Nearest Town
Telephone No. ()	<u>4</u> Miles <u>E</u> of <u>Steele</u>

Well / Borehole Data

Date drilling started: 9-10-13 Date drilling completed: 9-10-13 Hole depth: 120 Hole diameter: 2.5 in

Location of the source of any surface water used for drilling: Nearest Well

Method of dosing and volume of Chlorine used in drilling and development: _____

Logs run (circle all applicable): No log run Electric Gamma Ray Density Sonic Neutron Other: _____

Name of organization running log(s): _____

Purpose of borehole (check one): Water Well Geotechnical/Geological Investigation Ground Source Heat Pump
 Seismic Survey Other (describe) _____

If drilling is not related to water well construction, skip the remainder of this block

Purpose of Well (check one): Home Industrial Public Supply Irrigation Fish Culture Other: _____

If a flowing well, method of flow regulation: Valve _____ Other (describe) 2 valves

Static Water Level: 8 feet above or below (circle one) land surface Date measured: 9-11-13

Method of Measurement (circle one) steel tape electric tape air line other: _____

Well depth: 120 Well grouted to a depth of 10 feet Type of grout (circle one): Neat Cement Bentonite Mix

Casing length: 80 feet Casing diameter: 1 1/2 inches Type of casing: PVC

Screen length: 40 feet Screen diameter: 1 1/2 inches Type of screen: PVC

Screen slot size: 1/80 inches Setting depth: From 0 feet to 80 feet

Type of completion (circle all applicable): Gravel packed Underreamed Telescoped Open hole Natural Development

Other (describe): _____


Top of lap pipe or reduction in casing: _____ feet. *If telescoped or more than one screen, describe on next page*

Form: OLWR-~~507-1A~~ 0408 **RECEIVED**

SEP 25 2013
 BY: OLWR

The sketch below only required for water wells


If well telescopes, show depths on sketch.

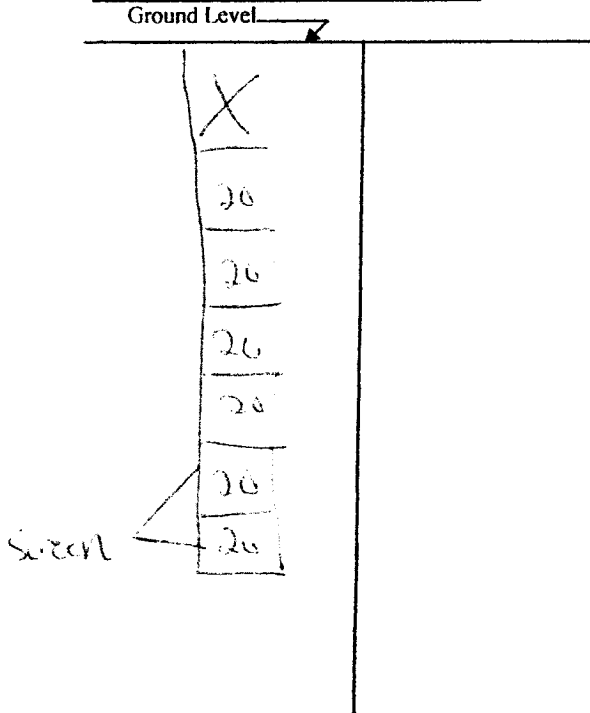

Description of formations encountered must be provided for all wells and boreholes, unless specifically exempted by regulations

Description of Formations Encountered	From (depth)	To (depth)
Gravel	Ground Level	20
Sand	20	40
Sand	40	60
Course sand	60	80
Sand + gravel	80	100
Sand + gravel	100	120

If more than one screen, show location of each on sketch

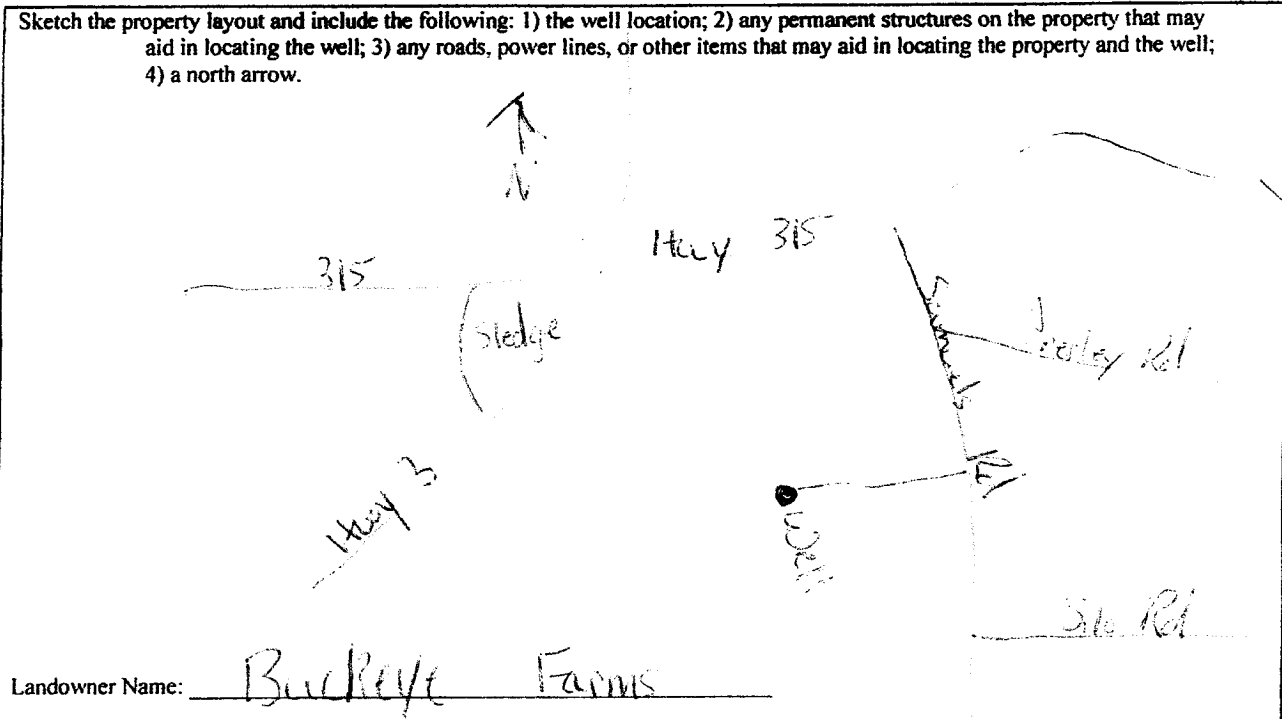

Landowner Name: Buckeye Farms

Form: OLWR-SWR-1A (04/08)

I certify that the well/borehole was drilled, constructed, and completed in accordance with all applicable requirements of the Mississippi Department of Environmental Quality and the Mississippi Department of Health regulations, if applicable, and state laws.

Print Name of Responsible Licensee and License No. [Handwritten Name] #5317 Date 9-11-13

Signature of Licensee [Handwritten Signature]

RECEIVED

SEP 25 2013

BY: OLWR

STATE WELL REPORT

Part 2

Pump Installer's Completion Report
 Mississippi Department of Environmental Quality
 Office of Land and Water Resources
 P.O. Box 2309
 Jackson, MS 39225-2309
 (601)961-5210
 (601) 360-0535 (fax)

County: Dennis
 Permit #: EW-47609
 Driller: Joel Juniper
 Date completed: 9-11-13
Copy information from block on Part 1

For Office Use Only:

Well #: E60
 Aquifer: _____

This part of the report must be completed by a licensed water well contractor or a licensed pump installer. A copy of Part 1 of the report must be attached and both parts filed with the Department at the above address within 30 days of well completion.

Well Owner Information	Well Location
Owner Name: <u>Buckeye Farms</u>	Latitude: <u>34-25-43</u> Longitude: <u>96-10-16</u>
Mailing Address: <u>P.O. Box 3060</u>	Method of Lat/Long (check one): Conventional Survey _____, USGS quad _____, Hand-held GPS <input checked="" type="checkbox"/> , Survey-grade GPS _____
City: <u>Lumb</u> State: <u>Ms</u> Zip Code: <u>38649</u>	<u>1/4</u> $\frac{1}{4}$ <u>SE</u> $\frac{1}{4}$, Sec <u>32</u> T. <u>17S</u> R. <u>11E</u>
Telephone No. () _____	<u>4</u> Miles <u>F</u> of <u>Sledge</u> (Distance) (Direction) (Nearest Town)

Pump Type (circle one)

Submersible Turbine Air Lift Centrifugal Flowing Well Jet Piston Rotary Other (describe): _____

Date Pump Installed: 9-11-13 Rated Pump Capacity: 1500 Gallons Per Minute

Is This Pump (circle one): New Repaired Replacement

Power Type (circle one)

Electric Diesel Gasoline Natural Gas Tractor PTO Windmill Other (describe): _____

Horse Power Rating of Motor: 5/8 Setting Depth: 0-50 feet Number of Stages: 3

Pump Test Data for Non Flowing Well

Date Well Tested: 9-11-13 Duration of Pump Test (minimum 4 hours): 5 hours

Static Water Level (A): 8 Feet Below Land Surface Pumping Water Level (B): 25 Feet Below Land Surface

Drawdown [(B) - (A)]: 17 Feet Below Land Surface Test Pumping Rate: 1500 Gallons Per Minute

Method of measurement (circle one): Steel tape Electric tape Air line Other (describe): _____

Pump Test Data for Flowing Well

Measured shut in head: _____ feet.

Well yielded 1500 GPM with a drawdown of 17 feet after 8 hours of pumping

Meter Installation

Meter Manufacturer: _____ Meter Serial Number: _____

Meter Model Number/Name: _____ Type of Meter: _____

Totalizer Register Unit and Multiplier Factor (AF x .001, gal x 1000, etc): _____

Installation Date: _____ Meter installed by: _____

Is This Meter (circle one): New Repaired Replacement

Important: By submitting the above information you are certifying that this meter was installed to manufacturer standards. For agricultural wells, a list of approved meters is on the MDEQ website.

I HEREBY CERTIFY that the above statements are true to the best of my knowledge.

Joel Juniper #5317 9-11-13 [Signature]
 Print Name of Pump Installer and License No. (if applicable) Date Signature of Pump Installer

RECEIVED
 SEP 25 2013
 BY: OLWR