	C1_1_ 1	Voll Report	
		Driller's Log	For Office Use Only:
County: Panola		nt of Environmental Quality	Aquifer:
County: Parala Permit # 6W-47245	Office of Land a	and Water Resources	
Driller TEDDY Carefs	1	Box 2309	Well# E63
Driffer 12500 (ac 3		n, MS 39225)961- 5210	L. S. Elevation:
Date drilling completed: 5/2/19		1- 5228 (fax)	E-log #:
]		
State Law requires that this repo Department at the above address	rt be prepared by the lic	ense holder responsible for l nation of drilling of the well	ne work and jueu wuu ine .or borehole.
Information on Well		Well or Bo	rehole Location
(Landowner if borehole is not f		24.21.20	
Owner Name Chich used	Farma	Latitude: 37°26'38	" Longitude: <u><u></u><u></u><u></u><u></u><u></u><u></u><u></u><u></u><u></u><u></u><u></u><u></u><u></u><u></u><u></u><u></u><u></u><u></u><u></u></u>
Owner Name Chic Color		Method of Lat/Long (circle or	e): Conventional Survey.
Mailing Address: Charle.	WESF		ODE Survey and GPS
STLY Ball	entire Rad		GPS, Survey-grade GPS
	<u>ry ry</u>	NW45W 14 Sec 29	Twn 075 Rng 094
<u>Sarchs</u> City Sta	15 38662	Distance Dimetion	Nearest Town
City Sta	ie Zip Code	Miles E	Nearest Town
Telephone No. ()	and the state of the		× 3
	Well / Bore	hale Data	
			0 A
Date drilling started: Date dr	illing completed: 52	Hole depth: //0	Hole diameter: 28
Location of the source of any surface water	er used for drilling	noreit	Well
Method of dosing and volume of Chloring	e used in drilling and devel	opment:	******
Logs run (circle all applicable) No log ru)ther:
Logs run (circle all applicable) No log run Name of organization running log(s):		Density Joine Medition	
		-i Leurstination Ground	Source Heat Pump
Purpose of borehole (check one): Water W	ell Geolechnical/Geol	ogical investigation Giodina	Source neutramp
Seismic S	SurveyOther (describe))	
If drilling is not related	to water well construction	n, skip the remainder of this blo	<u>ck</u>
Purpose of Well (check one): Home It	ndustrial Public Supply	Irrigation Fish Culture	Other:
•			
If a flowing well, method of flow regulation			
Static Water Level:feet ab	ove or below (circle one) l	and surface Date measured:	5/2/17
Method of Measurement (circle one) sto			
Well depth: $\underline{\mu} \mathcal{O}$ Well grouted to a dep	oth of 10^{feet} Type	of grout (circle one): Neat Ceme	nt Bentonite) Mix
Casing length: 70 feet Casin	a diameter: / L	inches Type of casing:	PUC.
	6		10 VIC
Casing length: leet Casin	11	inches Type of screen.	PVC
Screen length: <u><u><u></u></u><u><u></u><u></u><u></u><u></u><u></u><u></u><u></u><u></u><u></u><u></u><u></u><u></u><u></u><u></u><u></u><u></u></u></u>	en diameter:/6	inclus Type of soreen	
Screen length: <u><u><u></u></u><u><u></u><u></u><u></u><u></u><u></u><u></u><u></u><u></u><u></u><u></u><u></u><u></u><u></u><u></u><u></u><u></u></u></u>	en diameter:/6		
Screen length: <u><u>40</u> feet Screen Screen slot size: <u>650</u> inches</u>	en diameter:/6	feet to	70 feet
Screen length: <u><u>40</u> feet Screen Screen slot size: <u>650</u> inches</u>	en diameter:/6	feet to	70 feet
Screen length: <u><u>40</u> feet Screen Screen slot size: <u>650</u> inches</u>	Setting depth: From	feet to	600 feet
Screen length: <u>40</u> feet Screen Screen slot size: <u>650</u> inches Type of completion (circle all applicable):	Setting depth: From Sravel packed Underr Other (describe):	feet to	6eet feet feet Natural Development
Casing length:	Setting depth: From Sravel packed Underr Other (describe):	feet to	6eet feet feet Natural Development

Le and the Martin

E63


Panala GW-47245

The sketch below only required for water wells

1. 11

If well telescopes, show depths on sketch. Ground Level To (depth) To (depth) Image: Description of Formations Encountered From (depth) To (depth) Image: Description of Formations Encountered From (depth) To (depth) Image: Description of Formations Encountered From (depth) To (depth) Image: Description of Formations Encountered From (depth) To (depth) Image: Description of Formations Encountered From (depth) To (depth) Image: Description of Formations Encountered From (depth) To (depth) Image: Description of Formations Encountered From (depth) To (depth) Image: Description of Formations Encountered From (depth) To (depth) Image: Description of Formations Encountered From (depth) To (depth) Image: Description of Formations Encountered From (depth) To (depth) Image: Description of Formations Encountered From (depth) To (depth) Image: Description of Formations Encountered Formation of Formations Encountered Formation of Formations Encountered Image: Description of Formation of Formatio	The sketch below only required for water wells	Description of formations encountered wetts and boreholes, unless specifically	must be provided [exempted by regul	òr all ations
10 564 20 40 500 50 20 20 20 20 20 20 20 20 20 2	If well telescopes, show depths on sketch. Ground Level			
10 56-21 30 30 30 30 30 30 30 30 30 30	K	Pikt		_20
20 20 20 20 20 20 20 20 20 20		Sand	90	40
20 20 20 20 20 20 20 20 20 20		Sever	US VO	
20 20 20 20				80
20 20 20	10			
$\frac{20}{20}$				
20	20	Sand-T	100	
20				{
20	100			
	Fab			
	20			
	20			
]

If more than one screen, show location of each on sketch

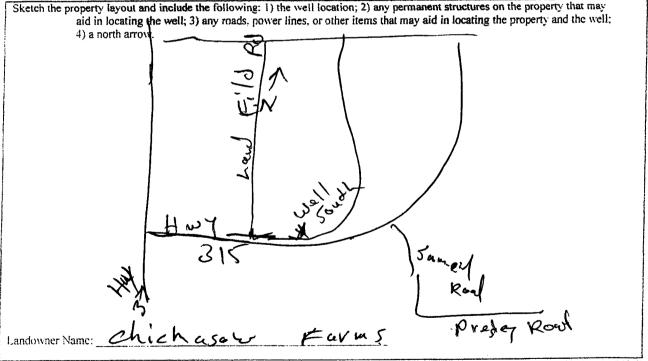

Form: OLWR-SWR-1A (04/08)

I certify that the well/borehole was drilled, constructed, and completed in accordance with all applicable requirements of the

Mississippi Department of Environmental Quality and the Mississippi Department of Health regulations, if applicable

laws. TEDDY LOT 5318 5/2/14 Print Name of Responsible Licensee and License No. Date Signature of Licensee

जम्म 💲 🛓 2014

STATE WELL REPORT	1
Part 2 For Office Use Only: Pump Installer's Completion Report	
Mississippi Department of Environmental Quality Well #:	
Merce JOLTED DELL SERVICE Office of Land and Water Resources Note completed: 5-2-14 P.O. Box 2309 Amiliar	
Jackson, MS 39225-2309 Adulet:	
(601)961-5210 (601) 360-0535 (fax)	
This part of the report must be completed by a licensed water well contractor or a licensed pump installer. A copy of Part 1	
of the report must be attached and both parts filed with the Department at the above address within 30 days of well completion. Well Owner Information Well Location	
Owner Name: <u>CHICKASAW F.4RmS</u> Latitude: <u>34-26.38</u> * Longitude: <u>90-10.34</u> .	
Mailing Address: <u>5764</u> BALLENTENE B Method of Lat/Long (check one): Conventional Survey,	
USGS quad, Hand-held GPS, Survey-grade GPS $Sec_2(5)$ $max = 38/1/1$ $A/1/1$ $sec_2(5)$ $max = 328 - 026$ $sec_2(5)$	
$\begin{array}{c ccccccccccccccccccccccccccccccccccc$	
Telephone No. 1002 487-3961 [Distance] (Distance) of <u>SLEDGE</u> (Nearest Town)	
Pump Type (circle one)	1
Submersible (Turbine Air Lift Centrifugal Flowing Well Jet Piston Rotary Other (<i>describe</i>):	
2000 AND 2000	
is This Pump (<i>circle one</i>): New Repaired Replacement	
Power Type (circle one)	
Electric Diesel Gasoline Natural Gas Tractor PTO Windmill Other (<i>describe</i>):	
Horse Power Rating of Motor: <u>60</u> Setting Depth: <u>70</u> feet Number of Stages: _/	
Pump Test Data for Non Flowing Well	I
Date Well Tested: buration of Pump Test (minimum 4 hours): hours	
Static Water Level (A): Feet Below Land Surface Pumping Water Level (B): Feet Below Land Surface	
Drawdown [(B) - (A)]:Feet Below Land Surface Test Pumping Rate: Gallons Per Minute	
Method of measurement (circle one): Steel tape Electric tape Air line Other (describe):	
Pump Test Data for Flowing Well	
Measured shut in head:feet.	
Well yieldedGPM with a drawdown of feet afterhours of pumping	
Moter Installation	
Meter Manufacturer: McChangler Motor Social Numbers 14-08744	
Meter Model Number/Name: MO3/O Type of Meter: GROWND WATER REC	CEIVED
	2 3 2014
Installation Date: <u>5-31-14</u> Meter installed by: <u>CIRCLIE S IFFE GATION</u>	40 LU14
Is This Meter (<i>circle one</i>): New Repaired Replacement BY:	OLWR
Important: By submitting the above information you are certifying that this meter was installed to manufacturer standards. For agricultural wells, a list of approved meters is on the MDEQ website.	
I HEREBY CERTIFY that the above statements are true to the best of my knowledge.	
$D_{a,b} = 2 H_{a,b} = 0$	
Print Name of Pump Installer and License No. (if applicable) Date Signature of Pump Installer	
Print Name of Pump Installer and License No. (<i>if applicable</i>) Date Signature of Pump Installer	m

*`\.
` S