State W	Vell Report For Office Use Only:			
Part 1-1	Driller's Log			
County: 1 CM 1010 Mississippi Departmen	et of Environmental Quality   Aquifer			
Permit # 4900 ) Office of Land a	nd Water Resources			
P.O.	00. 2000			
	n, MS 39225 961- 5210			
	1 5228 (fav)			
1				
State Law requires that this report be prepared by the lic	ense holder responsible for the work and filed with the			
Department at the above address within 30 days of comp	Well or Borehole Location			
Information on Well Owner				
(Landowner if borehole is not for a water well)	Latitude. 34 25 36 Longitude: 90 08.09.			
Owner Name Kiverside torm				
	Method of Lat/Long (circle one): Conventional Survey,			
Mailing Address: 98 Pleasant	USGS quad, Hand-held GPS Survey-grade GPS			
Grove Rd				
1 00/11	SW 1/4 SE 1/4 Sec 34 Twn 075 Rng 09W			
VALCED JUGGE	Direction Negrest Town			
City State Zip Code	Distance Direction Nearest Town  S Miles E of Sleage			
Telephone No. ()	J			
Well / Bore	hole Data			
Date drilling started: 7-15-15 Date drilling completed: 7-15-	K Hole depth: 115 Hole diameter: Hin			
Date drilling started: / [J-B] Date drilling completed. V D	D riose depuis			
Location of the source of any surface water used for drilling:	Jeavest Well			
Method of dosing and volume of Chlorine used in drilling and devel	opment:			
Logs run (circle all applicable) No log run Electric Gamma Ray Density Sonic Neutron Other:				
Name of organization running log(s):				
Purpose of borehole (check one): Water Well Geotechnical/Geological Investigation Ground Source Heat Pump				
Seismic Survey Other (describe)  If drilling is not related to water well construction, skip the remainder of this block				
Purpose of Well (check one): HomeIndustrial Public Supply	Irrigation Fish Culture Other:			
If a flowing well, method of flow regulation: Valve Other (describe)				
Static Water Level: 15 feet above or below (circle one) land surface Date measured: 7-15-15				
Method of Measurement (circle one) steel tape electric tape	air line other:			
Well depth: 115 Well grouted to a depth of 10 feet Type of grout (circle one): Neat Cement Bentonite Mix				
Casing length: 75 feet Casing diameter: 16 inches Type of casing: 000				
Screen length: 40 feet Screen diameter: 16	inches Type of screen:			

Setting depth: From \_

Gravel packed

Other (describe):

Underreamed Telescoped Open hole

feet. If telescoped or more than one screen, describe on next page

Screen slot size: \_\_\_\_\_\_\_\_\_\_\_\_\_\_\_

Type of completion (circle all applicable):

Top of lap pipe or reduction in casing:


Form: OLWR-SWR-1A (04/08)

Natural Development

feet

## The sketch below only required for water wells

If well telescopes, show depths on sketch.

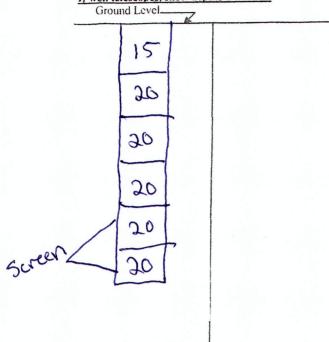

## Description of formations encountered must be provided for all wells and boreholes, unless specifically exempted by regulations

Description of Formations Encountered	From (depth)	To (depth)
Coumbo	Ground Level	1,50
Sandi	20	40
Sand	40	Leo
Course sand	60	80
gravel	80	100
gravel	100	1115
grader	100	1
		+
		-
	-	+
		+
	-	+
	-	+
		+
	<del>- </del>	-
		-
		ļ
		-
L		

If more than one screen, show location of each on sketch

aid in locating the well; 3) any roads.	ing: 1) the well location; 2) any permanent structures on the property that may is, power lines, or other items that may aid in locating the property and the well;
4) a north arrow.	
315	315
Stedge	Jump (
	Semus S
	L Marion
	Sib red Station
	Graver Form Shop
Landowner Name: Riverside	Farm

Form: OLWR-SWR-1A (04/08)

l certify that the well/borehole was	drilled, constructed, and complete	d in accordance with all applicable requirements of the
Mississippi Department of Environ	mental Quality and the Mississipp	i Department of Health regulations, if applicable, and state
laws.	C217 7-15-16	RECE

Joel Jumper 5311 1-15-15 Print Name of Responsible Licensee and License No.

Date

Signature of Licensee

AUG 3 1 2015

## STATE WELL REPORT

## County: PANOLA Permit #: GW- 4900 3 Driller: JOLL Jumple Date completed: 7-15-15 Copy information from block on Part 1

Part 2

Pump Installer's Completion Report

Mississippi Department of Environmental Quality
Office of Land and Water Resources
P.O. Box 2309
Jackson, MS 39225-2309
(601) 961-5210

For Office Use Only: Well #:
Aquifer:

(601) 360-0535 (fax) This part of the report must be completed by a licensed water well contractor or a licensed pump installer. A copy of Part 1 of the report must be attached and both parts filed with the Department at the above address within 30 days of well completion. Well Owner Information Well Location Latitude: 90 06 09 4 Longitude: 34 25 36 4 PLEASANT GROVE PO Method of Lat/Long (check one): Conventional Survey\_\_\_\_ USGS quad\_\_\_\_\_, Hand-held GPS\_\_\_\_\_, Survey-grade GPS\_ Pump Type (circle one) Air Lift Centrifugal Flowing Well Jet Piston Rotary Other (describe): 7-16-15 Rated Pump Capacity: 2200 Gallons Per Minute Date Pump Installed: Is This Pump (circle one): Repaired Replacement Power Type (circle one) Diesel Gasoline Natural Gas Tractor PTO Windmill Other (describe): Setting Depth: \_\_ feet Number of Stages: \_\_ Horse Power Rating of Motor: Pump Test Data for Non Flowing Well Date Well Tested: \_\_\_\_ Duration of Pump Test (minimum 4 hours): \_\_\_\_\_\_hours Static Water Level (A): \_\_\_\_\_\_ Feet Below Land Surface Pumping Water Level (B): \_\_\_\_\_ Feet Below Land Surface Drawdown [(B) - (A)]: \_\_\_\_\_\_Feet Below Land Surface Test Pumping Rate: \_\_\_\_\_ Gallons Per Minute Method of measurement (circle one): Steel tape Electric tape Air line Other (describe):\_\_\_\_\_ Pump Test Data for Flowing Well Measured shut in head: feet. Well yielded \_\_\_\_GPM with a drawdown of feet after\_ \_\_hours of pumping Meter Installation Meter Manufacturer: Meter Serial Number: Meter Model Number/Name: \_\_\_\_\_ Type of Meter:\_\_\_\_\_ Totalizer Register Unit and Multiplier Factor (AF x .001, gal x 1000, etc):\_\_\_\_\_ Installation Date: Meter installed by: \_\_\_\_\_ Is This Meter (circle one): New Repaired Replacement Important: By submitting the above information you are certifying that this meter was installed to manufacturer standards.

For agricultural wells, a list of approved meters is on the MDEQ website.

I HEREBY CERTIFY that the above statements are true to the best of my knowledge

Print Name of Pump Installer and License No. (if applicable)

8-7-15 Data

Signature of Pump Installer

Form: OLWR-SWR-1B (4/13)