

PANOLA  
 E 2000  
 8/20/76

MISSISSIPPI  
 BOARD OF WATER COMMISSIONERS  
 416 North State Street  
 Jackson, Mississippi 39201

WATER WELL DRILLERS LOG

8-20 1976 G.B. Cain Panola  
 date well completed firm name county well located

LANDOWNER: John Rush  
 Crenshaw Miss

description of formations encountered	from	to
Clay & Sand	0	24
Gravel	24	80
Pipe Clay Sand	80	143
Blue Clay	143	300
Sand	300	340

(mailing address)

WELL LOCATION:

sec. 15 T 7 N R 9 E  
 SW W  
 2 1/2 miles SE of Crenshaw  
 (distance) (direction) (nearest town)

WELL PURPOSE: HOME  
 (home, irrigation, municipal, industrial)

WELL COMPLETION DATA:

- (1) diameter (inches) 4
- (2) total depth (feet) 340
- (3) static water level (feet) 80 below top of ground.
- (4) casing Plastic, 340 (material) (depth)
- (size) if telescope see back.
- (5) screen 20' 320 (length) (depth to top)
- 4 Plastic (size) (material)
- (6) pump 3/4 15 (HP) (yield gpm)
- Elect (type power)
- (7) electric log N/D (yes or no)

(organization running log)

(8) how well bottom plugged Plug


RECEIVED  
 SEP 14 1976

DRILLERS REMARKS:

MISS. RD. OF WATER COMMISSIONERS

If well telescopes please sketch and show depths.

GROUND LEVEL

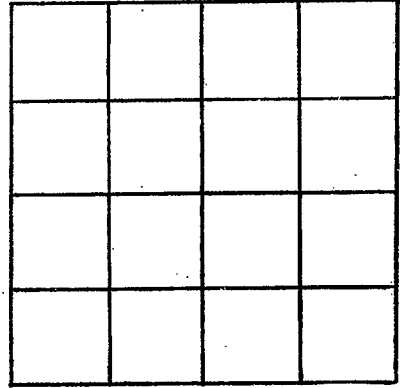

SECTION \_\_\_\_\_

Please indicate well location X.

ADDITIONAL INFORMATION

If more than one screen, show locations of each on sketch.