

PANOLA  
E 2001  
9-8-76

MISSISSIPPI  
 BOARD OF WATER COMMISSIONERS  
 416 North State Street  
 Jackson, Mississippi 39201

WATER WELL DRILLERS LOG

9-8 <sup>15E</sup> 1976 A B Cain Panola  
 date well completed firm name county well located

LANDOWNER: F.W. Dover  
Sledge Miss  
 (mailing address)  
 WELL LOCATION:  
 sec. 30 T 7 N R 9 E  
3 miles E of Sledge  
 (distance) (direction) (nearest town)

description of formations encountered	from	to
<u>Sand &amp; Clay</u>	<u>0</u>	<u>8</u>
<u>Sand</u>	<u>8</u>	<u>45</u>

WELL PURPOSE: HOME  
 (home, irrigation, municipal, industrial)

- WELL COMPLETION DATA:
- (1) diameter (inches) 4
  - (2) total depth (feet) 45
  - (3) static water level (feet) 15 below top of ground.
  - (4) casing Plastic, 45  
 (material) (depth)
  - If telescope see back.  
 (size)
  - (5) screen 10', .35  
 (length) (depth to top)
  - 4, Plastic  
 (size) (material)
  - (6) pump 1/2 15  
 (HP) (yield gpm)
  - Elect  
 (type power)
  - (7) electric log No  
 (yes or no)
  - (organization running log)
  - (8) how well bottom plugged Plug


DRILLERS REMARKS:

**RECEIVED**  
 SEP 14 1976

MISS. BD. OF WATER COMMISSIONERS

If well telescopes please sketch and show depths.

GROUND LEVEL

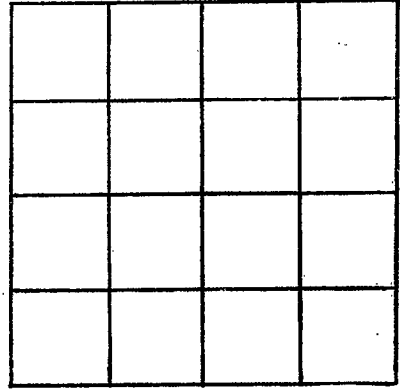

SECTION \_\_\_\_\_

Please indicate well location X.

ADDITIONAL INFORMATION

If more than one screen, show locations of each on sketch.