

PANOLA

E 2002

MISSISSIPPI BOARD OF WATER COMMISSIONERS 416 North State Street Jackson, Mississippi 39201

WATER WELL DRILLERS LOG

7-6-78 19 78 Hickwell Co Panola date well completed firm name county well located

LANDOWNER: Glen Wilson

description of formations encountered

from to

Stm Pt

Red clay

0 25

Sardin, Ms.

(mailing address)

Red Sand + gravel

25 60

WELL LOCATION:

sec 36 7 N R 9 E 1/2 miles S of Pleasant Grove (distance) (direction) (nearest town)

Red Sand + clay

60 127

White Sand

127 170

WELL PURPOSE: Home (home, irrigation, municipal, industrial)

WELL COMPLETION DATA:

- (1) diameter (inches) 4"
(2) total depth (feet) 170
(3) static water level (feet) 80 below top of ground
(4) casing PVC, 170 (material), (depth)
(5) screen 7, 163 (length), (depth to top)
(6) pump 1/2 (HP), 10 (yield gpm)
(7) electric log No (yes or no)

(organization running log)

(8) how well bottom plugged Cap

DRILLERS REMARKS:


RECEIVED

JUL 21 1978

MISS. BD. OF WATER COM

If well telescopes please sketch and show depths.

GROUND LEVEL

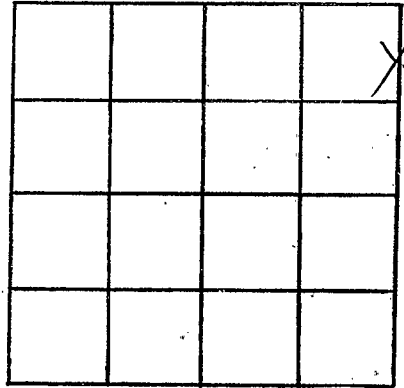

SECTION 36

Please indicate well location X.

ADDITIONAL INFORMATION

If more than one screen,
show locations of each on sketch.