

MISSISSIPPI DEPARTMENT OF NATURAL RESOURCES

Bureau of Land and Water Resources

Southport Mall

P.O. Box 10631

Jackson, Mississippi 39209

WATER WELL DRILLERS LOG

Panola  
E 2804

10-6 1983  
date well completed

NICKS WELL CO.  
firm name, No. 157

Panola  
county well located

LANDOWNER: Robert Brent  
Rt. 1 Box 22  
Crenshaw, Ms. 38621  
(mailing address)

WELL LOCATION:  
sec. 11 T 7 N R 9 E  
1 miles S of Longtown  
(distance) (direction) (nearest town)

WELL PURPOSE: Home  
(home, irrigation, municipal, industrial)

- WELL COMPLETION DATA:
- (1) diameter (inches) 4
  - (2) total depth (feet) 195
  - (3) static water level (feet) 140 <sup>below</sup> above top of ground.
  - (4) casing PVC 195  
(material) (depth)  
4"  
(size) if telescope see back.
  - (5) screen 10' 185'  
(length) (depth to top)  
1.013 PVC  
(size) (material)
  - (6) pump 3/4 10  
(HP) (yield gpm)  
220V  
(type power)
  - (7) electric log No  
(yes or no)
  - (organization running log)
  - (8) how well bottom plugged cap

description of formations encountered	from to	
<u>Red Clay</u>	<u>0</u>	<u>15</u>
<u>Red Sand</u>	<u>15</u>	<u>40</u>
<u>Gravel</u>	<u>40</u>	<u>55</u>
<u>Black Clay</u>	<u>55</u>	<u>150</u>
<u>Black Clay + White Sand</u>	<u>150</u>	<u>170</u>
<u>White Sand</u>	<u>170</u>	<u>195</u>


DRILLERS REMARKS:

DEPT. OF NATURAL RESOURCES  
BUREAU OF LAND & WATER RESOURCES

OCT 13 1983  
RECEIVED

If well telescopes please sketch and show depths.

GROUND LEVEL

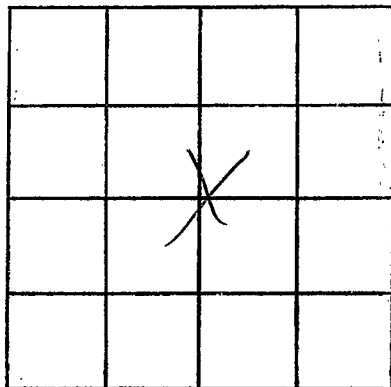

SECTION 11

Please indicate well location X.

ADDITIONAL INFORMATION

If more than one screen, show locations of each on sketch.