

PANOLA

F

WATER WELL DRILLERS LOG

10-10-62

Date: 10-10, 1962, Driller: J B Cain County Panola

(Name)

(1) Owner of Land:	Description & Color of Materials Sand, Clay, Red Clay, Shell, etc.	Thick- ness Feet	Depth Feet
Mrs Susie Shore	Clay	0	30
Route 2 Sardis Miss	Silt	30	90
	Sand	90	150
(2) Location: 1/4, 1/4, Sec. T R			
6 miles west of Sardis Drive, of Sardis			
(3) Topography: <input checked="" type="checkbox"/> (Hilly) <input type="checkbox"/> (Flat) <input type="checkbox"/> (Level)			
(4) Purpose of Well: Home			


Information upon completion of well:

- (1) Diameter 2 inches.
- (2) Total Depth 150 feet.
- (3) Water Level 105 feet below top of ground.
- (4) Cased to 150, Size 2"
- (5) Screen: Size 1 1/4, Length 6 FT
- (6) Were any formations sealed against pollution?
_____ yes, _____ no.

If YES depth of formation _____

Why _____

Drillers Remarks: _____

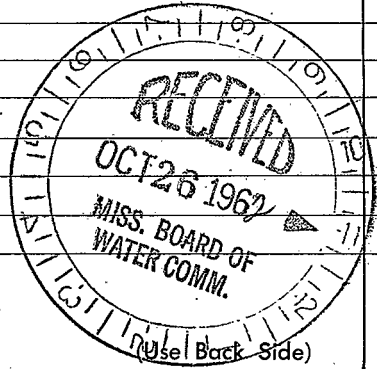

Well No.

