

CODED

CODED

Panola
71
1-16-69

MISSISSIPPI
BOARD OF WATER COMMISSIONERS
416 North State Street
Jackson, Mississippi 39201

WATER WELL DRILLERS LOG

JAN. 16 1969 WHITE BROS. PANOLA
date well completed firm name county well located

LANDOWNER:
WILLIAM STOKES
PLEASANT GROVE
(mailing address)

description of formations encountered	from	to
TOP SOIL	0	30
GRAVEL	30	75
MIXED SAND & YELLOW CLAY	75	105
BLUE CLAY	105	225
MED. FINE WHITE SAND	225	240

WELL LOCATION:
sec. 18 T. 7 N. R. 8 E
2 miles N of PLEASANT GROVE
(distance) (direction) (nearest town)

WELL PURPOSE: HOME
(home, irrigation, municipal, industrial)

WELL COMPLETION DATA:

(1) diameter (inches) 2

(2) total depth (feet) 240

(3) static water level (feet) 108 ^{below} above top of ground.

(4) casing STEEL, 236 FT.
(material) (depth)
2" if telescope see back.
(size)

(5) screen 4 FT., 236 FT.
(length) (depth to top)
1/4 STAINLESS STEEL
(size) (material)

(6) pump 3/4 3
(HP) (yield gpm)
ELE.
(type power)

(7) electric log NO
(yes or no)
(organization running log)

(8) how well bottom plugged STRAINER

CODED


JAN 21 1969

MISS. BD. OF
WATER COMMISSIONERS

DRILLERS REMARKS:

If well telescopes please sketch and show depths.

GROUND LEVEL

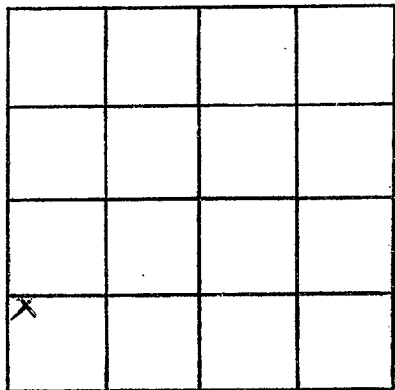

SECTION 18

Please indicate well location X.

ADDITIONAL INFORMATION

If more than one screen,
show locations of each on sketch.