

PANOLA

CODED

72

WATER WELL DRILLERS LOG

CODED

5-10-61

Date: 5/10, 19 61 Driller: Jas. R. Lipe County: Panola

(1) Owner of Land: Julius Johnson
 (Name)
Sardis, Miss
 (Address)

(2) Location: $\frac{1}{4}$, $\frac{1}{4}$, Sec. 30 T. 7 R. 8
5 RW
8 miles West of Sardis
 (distance) (direction) (Nearest Town)

(3) Topography: Level
 (Hilly) (Level)

(4) Purpose of Well: Domestic
 (Domestic, Irrigation, Municipal, Industrial, Other)

Description & Color of Materials Sand, Clay, Red Clay, Shell, etc.	Thick- ness Feet	Depth Feet
Clay	0	30
gravel & clay	30	50
Clay & sand	50	76
sand	76	100
expanding sand	100	115

Information upon completion of well:

(1) Diameter 2 inches.

(2) Total Depth 115 feet.

(3) Water Level 96 feet below top of ground.


(4) Cased to 108 Size 2"

(5) Screen: Size 1/4 Length 6'

(6) Were any formations sealed against pollution?
 yes, no.

If YES depth of formation _____
 Why _____

Drillers Remarks: _____

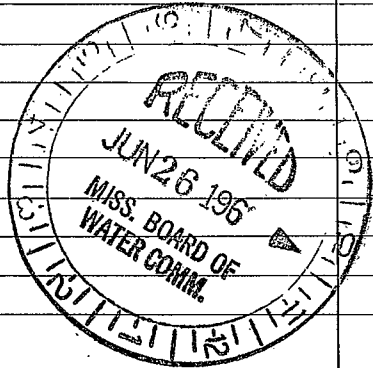

(Use Back Side)

Well No.

