

PANOLA
7-3
7-18-62

WATER WELL DRILLERS LOG

CODED

Date: 1/19, 1962, Driller: Jas. R. Lipe, County: Panola
(Name)


- (1) Owner of Land: Edd Hankins
(Name)
Como, Miss.
(Address)
- (2) Location: $\frac{1}{4}$, $\frac{1}{4}$, Sec. 6 T 8 R 5 W
5 miles West of Como
(distance) (direction) (Nearest Town)
- (3) Topography: Hilly
(Hilly) (Flat) (Level)
- (4) Purpose of Well: Domestic
(Domestic Irrigation
Municipal, Industrial, Other)

Description & Color of Materials Sand, Clay, Red Clay, Shell, etc.	Thick- ness Feet	Depth Feet
<u>Clay & top soil</u>	<u>0</u>	<u>15</u>
<u>clay</u>	<u>15</u>	<u>35</u>
<u>Clay & gravel</u>	<u>35</u>	<u>60</u>
<u>shale & sand</u>	<u>60</u>	<u>75</u>
<u>1 white sand</u>	<u>75</u>	<u>120</u>
<u>expanding sand</u>	<u>120</u>	<u>147</u>

Information upon completion of well:

- (1) Diameter 2 inches.
- (2) Total Depth 147 feet.
- (3) Water Level 120 feet below top of ground.
- (4) Cased to 140, Size 2"
- (5) Screen: Size 1 1/4, Length 6'
- (6) Were any formations sealed against pollution?
yes, no.

If YES depth of formation _____
Why _____
Drillers Remarks: _____

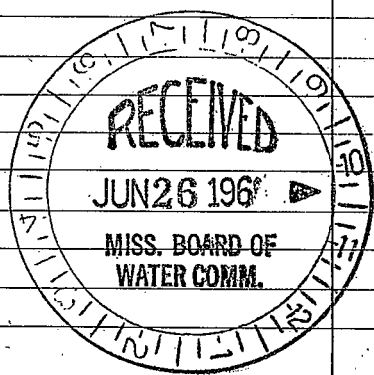

Retain this copy for your office files.

(Use Back Side)

Well No.

