

Panola
76
8-11-69

MISSISSIPPI
 BOARD OF WATER COMMISSIONERS
 416 North State Street
 Jackson, Mississippi 39201

WATER WELL DRILLERS LOG

8.11 1969 James R. Live Panola
 date well completed firm name county well located


LANDOWNER: <u>A.H. Wilson</u>	description of formations encountered	from	to
<u>Pleasant Grove</u> (mailing address)	<u>Clay</u>	<u>0</u>	<u>20</u>
	<u>"</u>	<u>20</u>	<u>40</u>
	<u>Clay and Sand</u>	<u>40</u>	<u>60</u>
	<u>Gravel</u>	<u>60</u>	<u>80</u>
	<u>"</u>	<u>80</u>	<u>100</u>
	<u>Sand and clay</u>	<u>100</u>	<u>120</u>
	<u>fine sand</u>	<u>120</u>	<u>156</u>
WELL LOCATION: sec. <u>30</u> T <u>7</u> N R <u>9</u> E <u>1</u> miles <u>east</u> of <u>Pleasant Grove</u> (distance) (direction) (nearest town)			
WELL PURPOSE: <u>home</u> (home, irrigation, municipal, industrial)			
WELL COMPLETION DATA:			
(1) diameter (inches) <u>4</u>			
(2) total depth (feet) <u>156</u>			
(3) static water level (feet) <u>90</u> below above top of ground.			
(4) casing <u>Plastic 150</u> (material) (depth)			
<u>4</u> If telescope see back. (size)			
(5) screen <u>6</u> <u>150</u> (length) (depth to top)			
<u>4</u> <u>Plastic</u> (size) (material)			
(6) pump <u>3/4</u> <u>10</u> (HP) (yield gpm)			
<u>Elec.</u> (type power)			
(7) electric log <u>no</u> (yes or no)			
(organization running log)			
(8) how well bottom plugged <u>Plastic plug</u>			
DRILLERS REMARKS:			

OCT 20 1969

MISS. BD. OF
 WATER COMM.

If well telescopes please sketch and show depths.

GROUND LEVEL

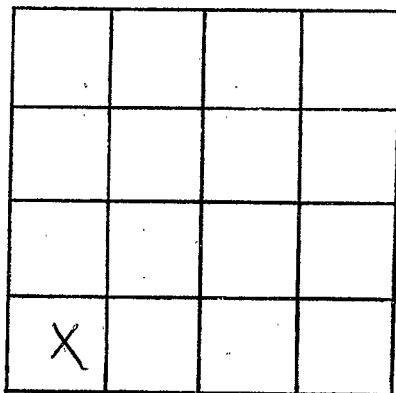

SECTION 30

Please indicate well location X.

ADDITIONAL INFORMATION

Lined area for additional information.

If more than one screen, show locations of each on sketch.