

PANOLA  
F8  
10-1-70

MISSISSIPPI  
BOARD OF WATER COMMISSIONERS  
416 North State Street  
Jackson, Mississippi 39201

**CODED**

WATER WELL DRILLERS LOG

~~10-1~~ 1970 JAMES R. LIPE Panola  
date well completed firm name county well located

LANDOWNER: Charles Cash  
Pleasant Grove Miss,  
Sledge Miss,  
(mailing address)

description of formations encountered	from	to
Clay	0	20
Sand and gravel	20	40
" " "	40	60
Gravel	60	80
Sand	80	100
"	100	156

WELL LOCATION:  
sec 30 T 2 N R 8 E  
1 miles North of Pleasant Grove  
(distance) (direction) (nearest town)

WELL PURPOSE: Home  
(home, irrigation, municipal, industrial)

WELL COMPLETION DATA:

- (1) diameter (inches) 4
- (2) total depth (feet) 106
- (3) static water level (feet) 50 below top of ground.
- (4) casing PVC 96  
(material) (depth)  
(size) If telescope see back.
- (5) screen 10 96  
(length) (depth to top)  
4 PVC  
(size) (material)
- (6) pump 3/4 10  
(HP) (yield gpm)  
Electric  
(type power)
- (7) electric log NO  
(yes or no)  
(organization running log)
- (8) how well bottom plugged PVC Plug

**CODED**


DEC 3 1970

MISS. BD. OF  
WATER COMM.

DRILLERS REMARKS:

If well telescopes please sketch and show depths.

GROUND LEVEL

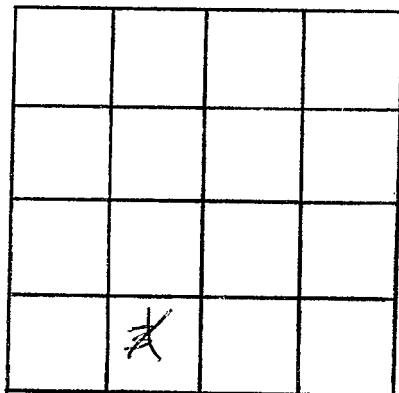

SECTION 30

Please indicate well location X.

ADDITIONAL INFORMATION

If more than one screen,  
show locations of each on sketch.