

PANOLA
F9
4-12-71

MISSISSIPPI
BOARD OF WATER COMMISSIONERS
416 North State Street
Jackson, Mississippi 39201

WATER WELL DRILLERS LOG

CODED

APRIL 12, 1971 J. LEON WHITE PANOLA
date well completed firm name county well located

LANDOWNER: WHITT Doolin

Corno Miss.

Rt. 2

(mailing address)

WELL LOCATION:

sec. 5 T 7 N R 8 E
(S) (W)
6 miles WEST of Corno
(distance) (direction) (nearest town)

WELL PURPOSE: HOME
(home, irrigation, municipal, industrial)

WELL COMPLETION DATA:

- (1) diameter (inches) 2"
(2) total depth (feet) 190 Ft.
(3) static water level (feet) 96 (below) above
top of ground.
(4) casing STEEL, 186 Ft.
(material) (depth)
2" If telescope see back.
(size)
(5) screen 4 Ft., 190 Ft.
(length) (depth to top)
1 1/4, STAINLESS STEEL
(size) (material)
(6) pump 3/4, 3
(HP) (yield gpm)
ELE.
(type power)
(7) electric log No.
(yes or no)

(organization running log)

(8) how well bottom plugged STRAINER

description of formations
encountered

from to

description of formations encountered	from	to
TOP SOIL	0	18
FINE SAND	18	26
WHITE CLAY	26	42
COARSE SAND	42	74
MIXED CLAY SAND	74	98
BLUE CLAY	98	170
MED WHITE SAND	170	190

CODED


MAY 6 1971

DRILLERS REMARKS:

MISS. BD. OF
WATER COMM.

If well telescopes please sketch and show depths.

GROUND LEVEL

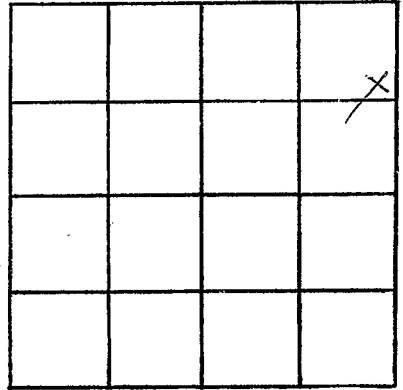

SECTION 5

Please indicate well location X.

ADDITIONAL INFORMATION

If more than one screen,
show locations of each on sketch.