

PANOLA
 F 10
 11-9-72

MISSISSIPPI
 BOARD OF WATER COMMISSIONERS
 416 North State Street
 Jackson, Mississippi 39201

CODED

WATER WELL DRILLERS LOG

11-9 1972 James R. Lipe Panola
 date well completed firm name county well located

LANDOWNER: E. P. McCloud

COMO

MISS

(mailing address)

WELL LOCATION:

sec 33 T 7 N R 8 E
 6 miles west of COMO
 (distance) (direction) (nearest town)

WELL PURPOSE: Home
 (home, irrigation, municipal, industrial)

WELL COMPLETION DATA:

- (1) diameter (inches) 4
- (2) total depth (feet) 200
- (3) static water level (feet) 80 below above top of ground.
- (4) casing PVC 190 (material) (depth)
 4 (size) if telescope see back.
- (5) screen 10 190 (length) (depth to top)
 4 PVC (size) (material)
- (6) pump 3/4 10 (HP) (yield gpm)
 Elec (type power)
- (7) electric log NO (yes or no)
 NO (organization running log)
- (8) how well bottom plugged PVC plug

description of formations encountered

	from	to
Clay	0	20
cl	20	40
Sand	40	60
cl	60	80
Gravel	80	100
cl	100	120
Blue clay	120	140
cl cl	140	160
cl cl	160	180
Water Sand	180	200


CODED

DEC 28 1972

DRILLERS REMARKS:

If well telescopes please sketch and show depths.

GROUND LEVEL

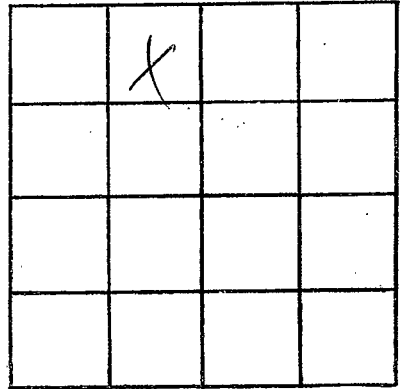

SECTION 33

Please indicate well location X.

ADDITIONAL INFORMATION

If more than one screen,
show locations of each on sketch.