

**PANOLA**  
**F12**  
**2-24-73**

MISSISSIPPI  
 BOARD OF WATER COMMISSIONERS  
 416 North State Street  
 Jackson, Mississippi 39201

**CODED**

**WATER WELL DRILLERS LOG**

2-24 1973 James R. Lipe Panola  
 date well completed firm name county well located

**LANDOWNER:**  
John Laney  
COMO Miss,  
 (mailing address)

**WELL LOCATION:**  
 sec. 7 T. 7 N. R. 8 E  
5 miles West of COMO  
 (distance) (direction) (nearest town)

**WELL PURPOSE:** HOME  
 (home, irrigation, municipal, industrial)

description of formations encountered	from	to
	ft	ft
<u>Clay</u>	<u>0</u>	<u>20</u>
<u>cl</u>	<u>20</u>	<u>40</u>
<u>sand</u>	<u>40</u>	<u>60</u>
<u>cc</u>	<u>60</u>	<u>80</u>
<u>Gravel</u>	<u>80</u>	<u>100</u>
<u>cl</u>	<u>100</u>	<u>120</u>
<u>Sand</u>	<u>120</u>	<u>140</u>
<u>ll</u>	<u>140</u>	<u>155</u>

**WELL COMPLETION DATA:**

(1) diameter (inches) 4

(2) total depth (feet) 155

(3) static water level (feet) 123 below above top of ground.

(4) casing PVC 145  
 (material) (depth)  
4 if telescope see back.  
 (size)

(5) screen 10 145  
 (length) (depth to top)  
4 PVC  
 (size) (material)

(6) pump 3/4 10  
 (HP) (yield gpm)  
elec  
 (type power)

(7) electric log NO  
 (yes or no)  
NO  
 (organization running log)

(8) how well bottom plugged PVC  
plug


**CODED**

**DRILLERS REMARKS:**

MAR 5 1973

If well telescopes please sketch and show depths.

GROUND LEVEL

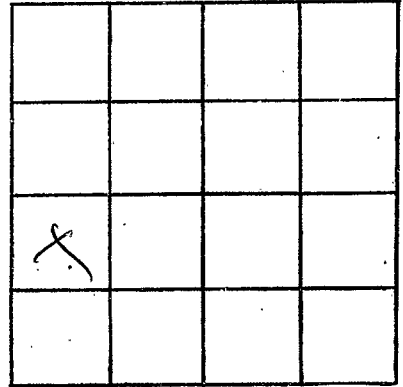

SECTION 2

Please indicate well location X.

ADDITIONAL INFORMATION

If more than one screen,  
show locations of each on sketch.