

PANOLA  
F 14  
3-18-74

MISSISSIPPI  
BOARD OF WATER COMMISSIONERS  
416 North State Street  
Jackson, Mississippi 39201

CODED

WATER WELL DRILLERS LOG

3-18 date well completed      1974 Lipe Well Co. firm name      Panola county well located

LANDOWNER:  
Tom L. King  
Como Miss.  
(mailing address)

description of formations encountered	from	to
Top Soil	0	20
red sand	20	40
" "	40	60
Gravel	60	80
" "	80	100
clay	100	120
sand and clay	120	140
White Sand	140	160

WELL LOCATION:  
sec. 5 T 2 N R 8 E  
6 miles west of Como  
(distance) (direction) (nearest town)

WELL PURPOSE:  
(home irrigation, municipal, industrial)

- WELL COMPLETION DATA:
- (1) diameter (inches) 4
  - (2) total depth (feet) 160
  - (3) static water level (feet) 90 below top of ground.
  - (4) casing PVC 150 (material) (depth)  
4 (size) If telescope see back.
  - (5) screen 10 150 (length) (depth to top)  
4 PVC (size) (material)
  - (6) pump 3/4 10 (HP) (yield gpm)  
elec (type power)
  - (7) electric log NO (yes or no)  
NO (organization running log)
  - (8) how well bottom plugged POC Plug

CODED

DECEMBER 1974


APR - 2 1974

DRILLERS REMARKS:

MISS. Bd. OF WATER COMMISSIONERS

If well telescopes please sketch and show depths.

GROUND LEVEL

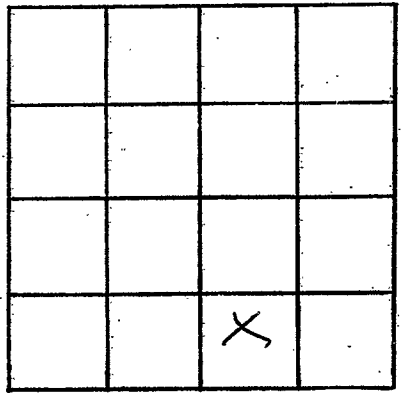

SECTION 5

Please indicate well location X.

ADDITIONAL INFORMATION

A series of horizontal lines for writing additional information, starting below the 'ADDITIONAL INFORMATION' header and extending down to the bottom of the page.

If more than one screen, show locations of each on sketch.