

PANOLA
 F17
 5-10-75

MISSISSIPPI
 BOARD OF WATER COMMISSIONERS
 416 North State Street
 Jackson, Mississippi 39201

CODED

WATER WELL DRILLERS LOG

May 10 1975 J. LEON WHITE 243 Panola
 date well completed firm name county well located

LANDOWNER: MALENA WEBB

description of formations encountered

from to

Como, Miss

TOP SOIL
 MIXED SAND & CLAY
 GRAVEL
 MED. WHITE SAND

0	35
35	65
65	90
90	115

Pat. R

(mailing address)

WELL LOCATION:

sec. 21 T. 7 N. R. 8 E
 9 miles N.W. of SARDIS
 (distance) (direction) (nearest town)

WELL PURPOSE: HOME
 (home, irrigation, municipal, industrial)

WELL COMPLETION DATA:

- (1) diameter (inches) 4"
- (2) total depth (feet) 115'
- (3) static water level (feet) 90' below top of ground.
- (4) casing PLASTIC 105' (material) (depth)
 4" (size) if telescope see back.
- (5) screen 10' 115' (length) (depth to top)
 4" (size) PLASTIC (material)
- (6) pump 1/2 (HP) 8-10 (yield gpm)
 FLE. (type power)
- (7) electric log NO. (yes or no)
 (organization running log)
- (8) how well bottom plugged STRAWER


RECEIVED
 MAY 13 1975

MISS. BD. OF WATER COMMISSIONERS

DRILLERS REMARKS:

If well telescopes please sketch and show depths.

GROUND LEVEL

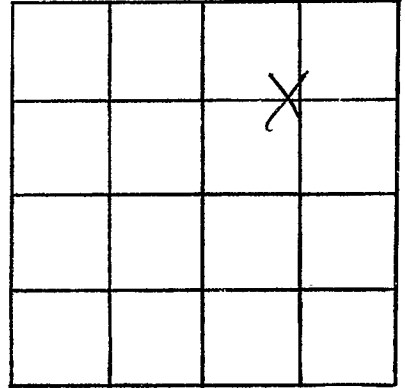

SECTION 21

Please indicate well location X.

ADDITIONAL INFORMATION

If more than one screen, show locations of each on sketch.