

Panola  
F 200  
10-23-75

MISSISSIPPI  
 BOARD OF WATER COMMISSIONERS  
 416 North State Street  
 Jackson, Mississippi 39201

WATER WELL DRILLERS LOG

Oct. 23 1975 LiPe Well Co. Panola  
 date well completed firm name county well located

LANDOWNER:  
Booker wright  
sardis Miss.  
 (mailing address)

| description of formations encountered | from | to  |
|---------------------------------------|------|-----|
| Top soil                              | 0    | 20  |
| sand                                  | 20   | 40  |
| Gravel                                | 40   | 60  |
| "                                     | 60   | 80  |
| sand                                  | 80   | 100 |
| "                                     | 100  | 150 |

WELL LOCATION:  
 sec. 27 T 7 N R. 15F  
4 miles west of sardis  
 (distance) (direction) (nearest town)

WELL PURPOSE:  
 (~~home~~) Irrigation, municipal, industrial)

WELL COMPLETION DATA:

(1) diameter (inches) 4

(2) total depth (feet) 150

(3) static water level (feet) 80 below top of ground.

(4) casing PVC 140  
 (material) (depth)

4 if telescope see back.  
 (size)

(5) screen 10 140  
 (length) (depth to top)

4 PVC  
 (size) (material)

(6) pump 3/4 10  
 (HP) (yield gpm)

eleg  
 (type power)

(7) electric log no  
 (yes or no)

no  
 (organization running log)


(8) how well bottom plugged PVC  
plug

DECEMBER 1975  
 OCT 30 1975

DRILLERS REMARKS:

If well telescopes please sketch and show depths.

GROUND LEVEL

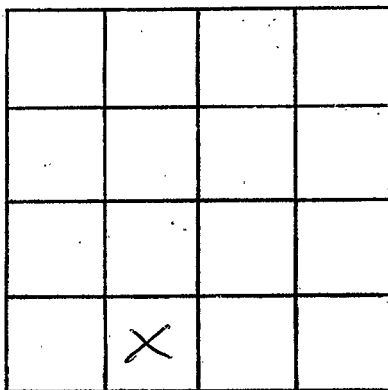

SECTION 27

Please indicate well location X.

ADDITIONAL INFORMATION

If more than one screen, show locations of each on sketch.