

PANOLA  
 F 2002  
 7/23/76

MISSISSIPPI  
 BOARD OF WATER COMMISSIONERS  
 416 North State Street  
 Jackson, Mississippi 39201

WATER WELL DRILLERS LOG

7-23-76  
 date well completed

15F Lot Smith Well Sr.  
 firm name

Panola  
 county well located

LANDOWNER:  
 C. H. Taber  
 Sandis, Miss.  
 (mailing address)  
 WELL LOCATION:  
 sec. 7 T. 8 N. R. 3 E. S. 8 W.  
 14 miles N.W. of Sandis  
 (distance) (direction) (nearest town)

WELL PURPOSE:  
 (home, irrigation, municipal, industrial)

WELL COMPLETION DATA:  
 (1) diameter (inches) 4"  
 (2) total depth (feet) 250  
 (3) static water level (feet) 120 below top of ground.  
 (4) casing plastic, 250 (material) (depth)  
 (size) If telescope see back.  
 (5) screen 20 (length) 230 (depth to top)  
 4" (size) plastic (material)  
 (6) pump 1/2 (HP) 10 (yield gpm)  
 E. Lee (type power)  
 (7) electric log (yes or no) no  
 (organization running log)  
 (8) how well bottom plugged

description of formations encountered	from	to
top soil	0	5
red clay	5	20
gravel	40	50
sand & clay	50	100
sand	100	250


RECEIVED  
 SEP 20 1976

MISS. BD. OF WATER COMMISSIONERS

DRILLERS REMARKS:

If well telescopes please sketch and show depths.

GROUND LEVEL

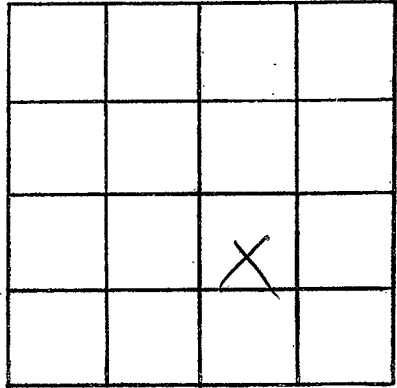

SECTION \_\_\_\_\_

Please indicate well location X.

ADDITIONAL INFORMATION

If more than one screen, show locations of each on sketch.