

PANOLA  
 F 2003  
 8/14/76

MISSISSIPPI  
 BOARD OF WATER COMMISSIONERS  
 416 North State Street  
 Jackson, Mississippi 39201

15F

WATER WELL DRILLERS LOG

8-14-76 19 date well completed  
 Bob Smith Well Dr. Panola firm name  
 Panola county well located


LANDOWNER:	description of formations encountered	from	to
Howard Hall			
Sardin, Ms. (mailing address)	red clay	5	40
WELL LOCATION:	gravel	40	130
sec. 33 T 7 N R 8 E	sand	130	240
10 miles W of Sardin			
(distance) (direction) (nearest town)			
WELL PURPOSE:			
(home) irrigation, municipal, industrial			
WELL COMPLETION DATA:			
(1) diameter (inches) 4			
(2) total depth (feet) 240			
(3) static water level (feet) 120 below top of ground.			
(4) casing plastic, 240 (material) (depth)			
(size) If telescope see back.			
(5) screen 20, 230 (length) (depth to top)			
4 plastic (size) (material)			
(6) pump 3/4, 15 (HP) (yield gpm)			
Elec (type power)			
(7) electric log (yes or no) (no)			
(organization running log)			
(8) how well bottom plugged			
DRILLERS REMARKS:			

RECEIVED  
 SEP 20 1976

MISS. BD. OF WATER COMM

If well telescopes please sketch and show depths.

GROUND LEVEL

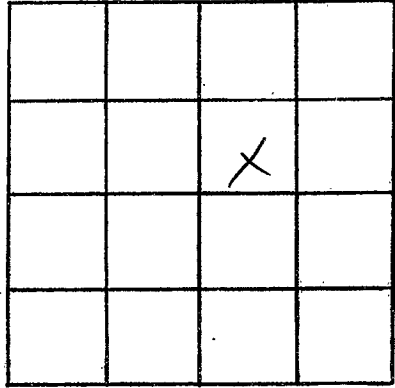

SECTION \_\_\_\_\_

Please indicate well location X.

ADDITIONAL INFORMATION

If more than one screen, show locations of each on sketch.