

PANOLA
 F 2004
 8/19/76

MISSISSIPPI
 BOARD OF WATER COMMISSIONERS
 416 North State Street
 Jackson, Mississippi 39201

WATER WELL DRILLERS LOG

8-19 1976 Lipe well Co Panola
 date well completed firm name county well located

LANDOWNER:
 Ruffin Holden
 Sardi's MS.
 (mailing address)

| description of formations encountered | from | to |
|---------------------------------------|------|-----|
| TOP Soil | 0 | 20 |
| red sand | 20 | 40 |
| gravel | 40 | 60 |
| " | 60 | 130 |
| sand | 130 | 180 |

WELL LOCATION:
 sec. 13 T 7 N R 8 E S 8 W
 4 miles west of Sardi's
 (distance) (direction) (nearest town)

WELL PURPOSE:
 (home, irrigation, municipal, industrial)

- WELL COMPLETION DATA:
- (1) diameter (inches) 4
 - (2) total depth (feet) 180
 - (3) static water level (feet) 60 below above top of ground.
 - (4) casing PVC, 170 (material) (depth)
 4 (size) if telescope see back.
 - (5) screen 10, 170 (length) (depth to top)
 4, PVC (size) (material)
 - (6) pump 3/4, 10 (HP) (yield gpm)
 elec. (type power)
 - (7) electric log NO (yes or no)
 NO (organization running log)
 - (8) how well bottom plugged PVC CAP


DRILLERS REMARKS:

RECEIVED
 AUG 21 1976

MISS. BD. OF WATER COMMISSIONERS

If well telescopes please sketch and show depths.

GROUND LEVEL

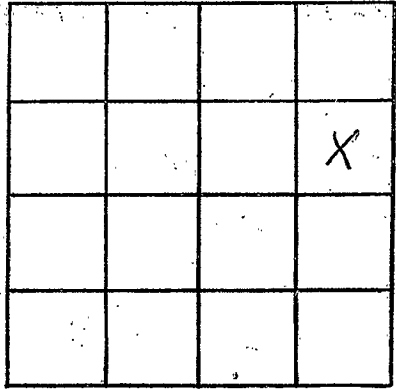

SECTION 13

Please indicate well location X.

ADDITIONAL INFORMATION

If more than one screen,
show locations of each on sketch.