

PANOLA
 F 2005
 1-28-77

MISSISSIPPI
 BOARD OF WATER COMMISSIONERS
 416 North State Street
 Jackson, Mississippi 39201

WATER WELL DRILLERS LOG

1-28-77 date well completed 155 77 J.R. Cain firm name Panola county well located

LANDOWNER: Tim Walton
Come Min
 (mailing address)

WELL LOCATION:
 sec. 5 T 7 N R 8 E
6 miles W of Come
 (distance) (direction) (nearest town)

WELL PURPOSE: Home
 (home, irrigation, municipal, industrial)

WELL COMPLETION DATA:
 (1) diameter (inches) 4"
 (2) total depth (feet) 230
 (3) static water level (feet) 120 ^{below}/_{above} top of ground.
 (4) casing Plastic, 230
 (material) (depth)
 (size) if telescope see back.
 (5) screen 10', 220
 (length) (depth to top)
4", Plastic
 (size) (material)
 (6) pump 3/4, 10
 (HP) (yield gpm)
Elect
 (type power)
 (7) electric log (yes or no)
 (organization running log)
 (8) how well bottom plugged Plug

description of formations encountered	from	to
Clay	0	30
Clay & Sand str	30	70
Gravel	70	85
Clay	85	220
Sand	220	230


DRILLERS REMARKS:

RECEIVED
 FEB 14 1977

MISS. BD. OF WATER COMM.

If well telescopes please sketch and show depths.

GROUND LEVEL

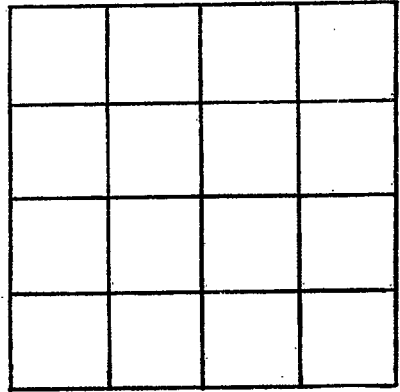

SECTION _____

Please indicate well location X.

ADDITIONAL INFORMATION

If more than one screen, show locations of each on sketch.