

PANOLA
 F 2506
 2/11/77

MISSISSIPPI
 BOARD OF WATER COMMISSIONERS
 416 North State Street
 Jackson, Mississippi 39201

WATER WELL DRILLERS LOG

2-11 1977 ^{15F} Hicks Well Co Panola
 date well completed firm name county well located

LANDOWNER: Pat Ware
 Rt. 2, Box 187
 Como, Mo.
 (mailing address)

description of formations encountered	from	to
	Red Clay	0
Red Sand & Clay	40	75
Gravel	75	120
White Sand	120	147

WELL LOCATION:
 sec. 16 T-7 N R-8 E
 9 miles SW of Como
 (distance) (direction) (nearest town)

WELL PURPOSE: Home
 (home, irrigation, municipal, industrial)


- WELL COMPLETION DATA:
- (1) diameter (inches) 4
 - (2) total depth (feet) 147
 - (3) static water level (feet) 125 below above top of ground.
 - (4) casing PVC, 147,
 (material) (depth)
 - (size) If telescope see back.
 - (5) screen 7ft, 140
 (length) (depth to top)
 - 4", Shovel type
 (size) (material)
 - (6) pump 1/2, 10
 (HP) (yield gpm)
 - 220V
 (type power)
 - (7) electric log No
 (yes or no)
 - (organization running log)
 - (8) how well bottom plugged Cap

DRILLERS REMARKS:

RECEIVED
 FEB 21 1977
 MISS. BD. OF WATER COMMISSIONERS

If well telescopes please sketch and show depths.

GROUND LEVEL

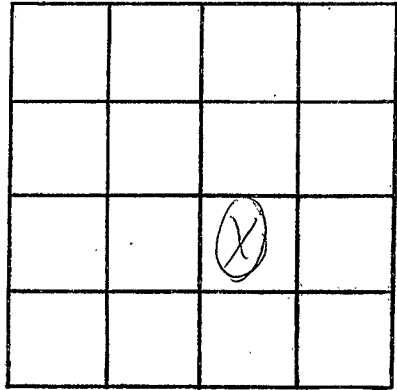

SECTION 16

Please indicate well location X.

ADDITIONAL INFORMATION

If more than one screen, show locations of each on sketch.