

PANOLA
F 2009
8-16-78

**MISSISSIPPI
BOARD OF WATER COMMISSIONERS**
416 North State Street
Jackson, Mississippi 39201

WATER WELL DRILLERS LOG

8-16-1978 date well completed 78 Hicks well co firm name PANOLA county well located

LANDOWNER: PAUL RODWIN
RT-2 BOX 156
Sardis, Miss
(mailing address)

description of formations encountered	from	to
Red clay	0	15
white clay & sand	15	220
white sand	230	240
white clay & sand	240	270
white sand	270	290

WELL LOCATION:
sec. 5 T. 7 N. R. 8 E.
8 miles W of COMO
(distance) (direction) (nearest town)

WELL PURPOSE: HOME
(home, irrigation, municipal, industrial)

WELL COMPLETION DATA:

(1) diameter (inches) 4"

(2) total depth (feet) 290

(3) static water level (feet) 125 below top of ground.

(4) casing PVC, 290
(material) (depth)
(size) If telescope see back.


(5) screen 15' 15'
(length) (depth to top)
4" DB SLOTTED
(size) (material)

(6) pump 3/4 10
(HP) (yield gpm)
220 Elec
(type power)

(7) electric log NO
(yes or no)
(organization running log)


(8) how well bottom plugged cap

DRILLERS REMARKS:

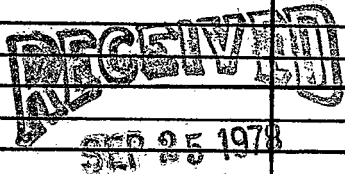

If well telescopes please sketch and show depths.

GROUND LEVEL

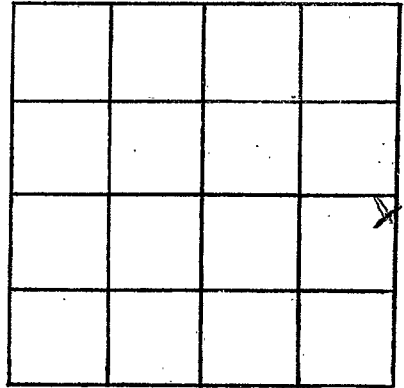

SECTION _____

Please indicate well location X.

ADDITIONAL INFORMATION

If more than one screen,
show locations of each on sketch.