

PANOLA
 F 2010
 12-70-78

MISSISSIPPI
 BOARD OF WATER COMMISSIONERS
 416 North State Street
 Jackson, Mississippi 39201

WATER WELL DRILLERS LOG


Dec-30-1978 date well completed
 78 North Miss Well Drilling Panola firm name
 Panola county well located

LANDOWNER:	description of formations encountered	from	to
Mike Sigler	Clay	0	25
(mailing address)	Red Shale	25	60
WELL LOCATION:	Sand	60	153
sec. 33 T 7 N R 2 E S4 W1 6 1/2 miles W of Sardis (distance) (direction) (nearest town)			
WELL PURPOSE: Home (home, irrigation, municipal, industrial)			
WELL COMPLETION DATA:			
(1) diameter (inches) 4"			
(2) total depth (feet) 153			
(3) static water level (feet) 80 below top of ground.			
(4) casing Plastic, 153' (material) (depth)			
(size) If telescope see back.			
(5) screen 10' (length) (depth to top)			
4 Plastic (size) (material)			
(6) pump 1/2 10 (HP) (yield gpm)			
Elec (type power)			
(7) electric log No (yes or no)			
(organization running log)			
(8) how well bottom plugged Wash Bottom			
DRILLERS REMARKS:			

Miss. Board of Water Comm.
 JUL 30 1979
 RECEIVED

If well telescopes please sketch and show depths.

GROUND LEVEL

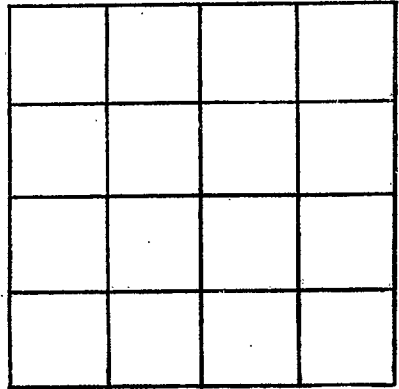

SECTION _____

Please indicate well location X.

ADDITIONAL INFORMATION

If more than one screen, show locations of each on sketch.