




If well telescopes please  
sketch and show depths.

GROUND LEVEL

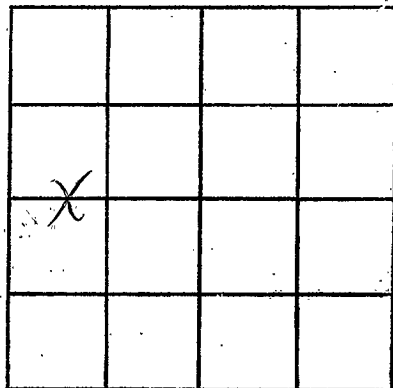

SECTION 25

Please indicate well location: X.

ADDITIONAL INFORMATION

If more than one screen,  
show locations of each on sketch.