

MISSISSIPPI DEPARTMENT OF NATURAL RESOURCES

Bureau of Land and Water Resources

Southport Mall

P.O. Box 10631

Jackson, Mississippi 39209

WATER WELL DRILLERS LOG

Panola
F 2014
5/12/81

5-72 1981 Hicks Well Co. Panola
date well completed firm name county well located

LANDOWNER: Ronald F. Futer
Rt. 1 Box 387
Batesville, Mo.
(mailing address)

description of formations encountered	from	to
<u>Red Clay</u>	<u>0</u>	<u>25</u>
<u>Gravel</u>	<u>25</u>	<u>65</u>
<u>White Sand</u>	<u>65</u>	<u>107</u>

WELL LOCATION:
sec 21 T 7 N R 8 E
6 miles W of Excelsior
(distance) (direction) (nearest town)

WELL PURPOSE: Home
(home, irrigation, municipal, industrial)


WELL COMPLETION DATA:

- (1) diameter (inches) 4
- (2) total depth (feet) 107
- (3) static water level (feet) 70 below above top of ground.
- (4) casing PVC 1.07
(material) (depth)
 if telescope see back.
(size)
- (5) screen 2 100
(length) (depth to top)
4" rimmed type
(size) (material)
- (6) pump 1/2 10
(HP) (yield gpm)
220V
(type power)
- (7) electric log Yes
(yes or no)

(organization running log)


(8) how well bottom plugged Cap

DRILLERS REMARKS:

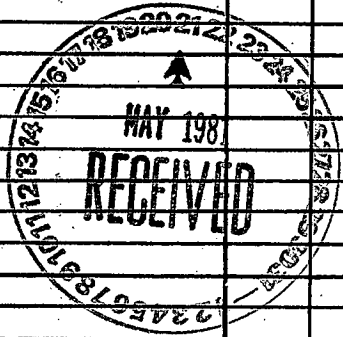

If well telescopes please sketch and show depths.

GROUND LEVEL

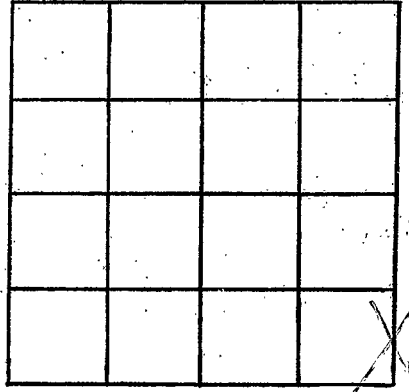

SECTION 21

Please indicate well location X.

ADDITIONAL INFORMATION

If more than one screen,
show locations of each on sketch.