

MISSISSIPPI DEPARTMENT OF NATURAL RESOURCES

Bureau of Land and Water Resources

Southport Mall

P.O. Box 10631

Jackson, Mississippi 39209

WATER WELL DRILLERS LOG

PANOLA
F 2015
10-13-81

HICKS WELL COMPANY

Panola

10-13 1981
date well completed

RT. 1 - BOX 137
firm name

county well located

LANDOWNER: *Carla Anne M.B. Church*

description of formations encountered

from

to

1/8 Clarence Taylor

Brown Clay

0 55

*P.O. Box 352, Como, Mo.
(mailing address) 38619*

Shovel

55 90

WELL LOCATION:

sec. 16 T 7 N R 8 E
5 miles SW of Como
(distance) (direction) (nearest town)

White Sand

90 125

WELL PURPOSE: *church*
(home, irrigation, municipal, industrial)

WELL COMPLETION DATA:

(1) diameter (inches) 4
(2) total depth (feet) 125
(3) static water level (feet) 70 below above top of ground.

(4) casing PVC 125
(material) (depth)

✓ (size) if telescope see back.

(5) screen 7 118
(length) (depth to top)

4" gravel type
(size) (material)

(6) pump 1/2 10
(HP) (yield gpm)

115-V
(type power)

(7) electric log No
(yes or no)

(organization running log)

(8) how well bottom plugged Cap

DEPT. OF NATURAL RESOURCES
BUREAU OF LAND & WATER RESOURCES


OCT 16 1981

RECEIVED

DRILLERS REMARKS:

If well telescopes please sketch and show depths.

GROUND LEVEL

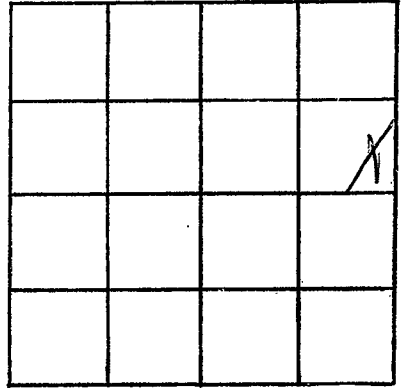

SECTION 16

Please indicate well location X.

ADDITIONAL INFORMATION

If more than one screen,
show locations of each on sketch.