

Parola
F 2016

MISSISSIPPI
 BOARD OF WATER COMMISSIONERS
 416 North State Street
 Jackson, Mississippi 39201

WATER WELL DRILLERS LOG

4/8/84 1984 Lipe Well Supply Parola
 date well completed firm name county well located

LANDOWNER: Bill Mathershead
Mathershead
Phoent Drive

description of fomations encountered

from to

None
 (mailing address)

Sand & clay
clay
clay

0 20
20 40
40 100

WELL LOCATION:

sec. 6 T 7 N R. 8 E
8 miles W of Sorris
 (distance) (direction) (nearest town)

WELL PURPOSE: Industrial
 (home, irrigation, municipal, industrial)

WELL COMPLETION DATA:

- (1) diameter (inches) 4
- (2) total depth (feet) 100
- (3) static water level (feet) 10 ^{below}/_{above} top of ground.
- (4) casing PVC 90
 (material) (depth)
4"
 (size) if telescope see back.
- (5) screen 10 90
 (length) (depth to top)
4 PVC
 (size) (material)
- (6) pump 3 45
 (HP) (yield gpm)
Eec
 (type power)
- (7) electric log X
 (yes or no)
 (organization running log)
- (8) how well bottom plugged PVC cap

DEPT. OF NATURAL RESOURCES
 BUREAU OF LAND & WATER RESOURCES


APR 23 1984

RECEIVED

DRILLERS REMARKS:

If well telescopes please sketch and show depths.

GROUND LEVEL

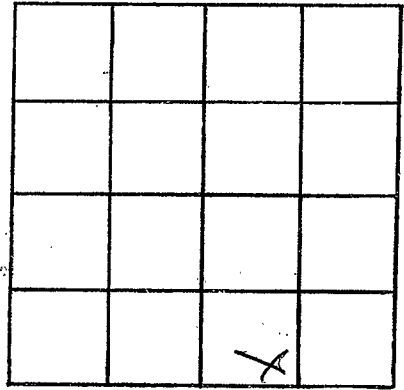

SECTION _____

Please indicate well location X.

ADDITIONAL INFORMATION

If more than one screen,
show locations of each on sketch.