

MISSISSIPPI DEPARTMENT OF NATURAL RESOURCES

Bureau of Land and Water Resources

Southport Mall

P.O. Box 10631

Jackson, Mississippi 39209

WATER WELL DRILLERS LOG

HICKS WELL COMPANY

RT. 1 BOX 157

SENATORIA, MISS.

Panola

Panola
2017

date well completed 8-1-1985

county well located

LANDOWNER: Willie B. Dillard

Rt # 2 Box 220

Como MS 39819
(mailing address)

WELL LOCATION:

sec. 31 T. 7 N. R. 8 E. S. W.
8 miles W of Sardis
(distance) (direction) (nearest town)

WELL PURPOSE: Home
(home, irrigation, municipal, industrial)

WELL COMPLETION DATA:

- (1) diameter (inches) 4"
- (2) total depth (feet) 130'
- (3) static water level (feet) 100' below top of ground.
- (4) casing: PVC, 120' (material), (depth)
4" (size) if telescope see back.
- (5) screen: 10' (length), 120' (depth to top)
.013 (size), PVC (material)
- (6) pump: 3/4 (HP), 10 (yield gpm)
220 V (type power)
- (7) electric log No (yes or no)

(organization running log)

(8) how well bottom plugged Cap

description of formations encountered	from	to
Red clay	0	10
Red Sand	10	30
Gravel	30	50
White Sand & clay	50	80
White Sand	80	130


RECEIVED
NOV - 7 1985

DRILLERS REMARKS:

Department of Natural Resources
Bureau of Land & Water Resources

If well telescopes please sketch and show depths.

GROUND LEVEL

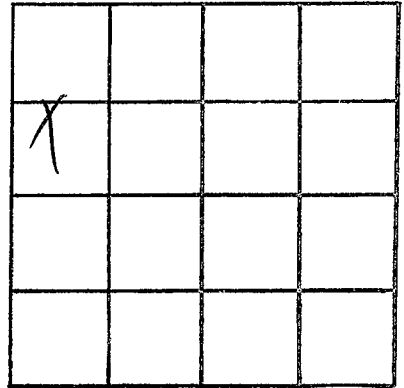

SECTION 31

Please indicate well location X.

ADDITIONAL INFORMATION

If more than one screen,
show locations of each on sketch.