

PANOLA

G

WATER WELL DRILLERS LOG

8-1-63

Date: 8-1, 1963, Driller: J. B. Cain County Panola

(Name)

(1) Owner of Land: Fred Williams (Name) Sanders (Address)

Description & Color of Materials Sand, Clay, Red Clay, Shell, etc.	Thick- ness Feet	Depth Feet
Bro @	0	40
Gravel	40	115
Sand	115	170

(2) Location: 1/4, 1/4, Sec. T R, 1 miles North of Sanders (distance) (direction) (Nearest Town)

(3) Topography: (Hilly) (Flat) (Level)

(4) Purpose of Well: Home (Domestic Irrigation Municipal, Industrial, Other)

Information upon completion of well:

(1) Diameter 2 inches.

(2) Total Depth 170 feet.

(3) Water Level 98 feet below top of ground.

(4) Cased to 170, Size 2"


(5) Screen: Size 2", Length 6" Screen locked in

(6) Were any formations sealed against pollution? yes, no.

If YES depth of formation

Why

Drillers Remarks:

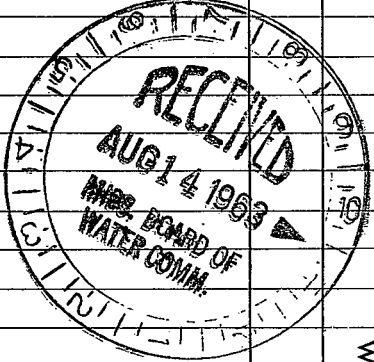

Well No.

(Use Back Side)

