

MISSISSIPPI
BOARD OF WATER COMMISSIONERS
416 North State Street
Jackson, Mississippi 39201

CODED

WATER WELL DRILLERS LOG

October 19 67 Carloss Well Supply Co. Panola
date well completed firm name county well located

LANDOWNER:

City of Sardis

Sardis, Mississippi
(mailing address)

WELL LOCATION:

sec. 35 T. 7 N. R. 7 E. S. W.

SOUTH OF TOWN

(distance) miles (direction) of (nearest town)

WELL PURPOSE: Municipal
(home, irrigation, municipal, industrial)

WELL COMPLETION DATA:

- (1) diameter (inches) 12"
(2) total depth (feet) 1144'
(3) static water level (feet) 167' above top of ground.

- (4) casing Blk Stl. 1030'
(material) (depth)

No. / If telescope see back.
(size)

- (5) screen 100' 1041'
(length) (depth to top)

8" Stainless Steel
(size) (material)

- (6) pump 100 750
(HP) (yield gpm)

Electric
(type power)

- (7) electric log Yes
(yes or no)

U.S.G.S. - WRD
(organization running log)

- (8) how well bottom plugged B.P. Valve

description of formations encountered

from

to

Top Soil-Sandy Clay

0

61

Sand, Gravel, Clay Strks

61

243

Brown Clay

243

261

Hard Rock

261

264

Brown Clay

264

276

Hard Rock

276

279

Sandy Clay

279

349

Sandy Clay-Shale

349

465

Shale w/Strks Sand

465

558

Strks Sand, Clay, Shale

558

752

Hard Rock

752

753

Strks Sand, Shale, Clay

753

935

Blue Shale

935

957

Strks Sand, Shale, Clay

957

1012

Hard Rock

1012

1013

Shale

1013

1026

Sand

1026

1049

Sandy Shale & Sand

1049

1085

Sand w/Strks Shale

1085

1147

Sandy Shale

1147

1186

Shale

1186

1202

Sandy Shale

1202

1341

Hard Rock

1341

1342

Shale

1342

1446

Hard Rock

1446


1447

Shale

1447

1600

CODED

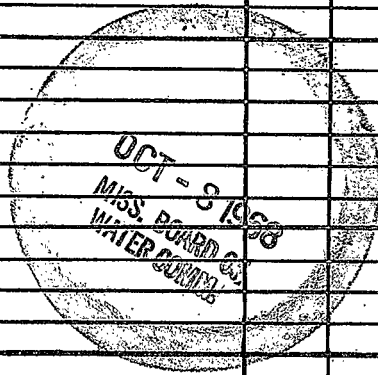

DRILLERS REMARKS: Another

"TROUBLE FREE" Carloss Water
well

If well telescopes please
sketch and show depths.

GROUND LEVEL

SECTION _____

Please indicate well location X.

ADDITIONAL INFORMATION

If more than one screen,
show locations of each on sketch.