

PANOLA
 G 15
 4-68

MISSISSIPPI
 BOARD OF WATER COMMISSIONERS
 416 North State Street
 Jackson, Mississippi 39201

CODED

CODED

WATER WELL DRILLERS LOG

4. 5 1968 date well completed
 James R. Lipe firm name
 Panola county well located

LANDOWNER: Christine Bethel

description of formations encountered

from to

Sardis
Miss

Top soil	0	20
Clay	20	40
Sand and gravel	40	60
" " "	60	80
White clay and sand	80	100
" " "	100	120
White sand	120	148

(mailing address)

WELL LOCATION:

sec. 31 T23N R2W
3 miles W of Sardis
 (distance) (direction) (nearest town)

WELL PURPOSE:
 (home, irrigation, municipal, industrial)

WELL COMPLETION DATA:

- (1) diameter (inches) 2"
- (2) total depth (feet) 148'
- (3) static water level (feet) 80 below top of ground.
- (4) casing Galv. 142'
 (material) (depth)

(size) If telescope see back.

- (5) screen 6' 142'
 (length) (depth to top)

1/4 Gravel
 (size) (material)

- (6) pump 3/4 3
 (HP) (yield gpm)

E100.
 (type power)


- (7) electric log no
 (yes or no)

(organization running log)

- (8) how well bottom plugged

DRILLERS REMARKS:

CODED

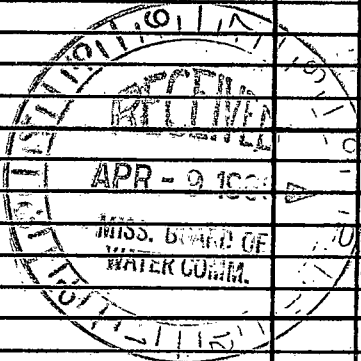

If well telescopes please sketch and show depths.

GROUND LEVEL

			X

SECTION 31

Please indicate well location X.

ADDITIONAL INFORMATION

If more than one screen, show locations of each on sketch.