

Panola
 G 16
 6-4-69

MISSISSIPPI
 BOARD OF WATER COMMISSIONERS
 416 North State Street
 Jackson, Mississippi 39201

CODED

WATER WELL DRILLERS LOG

JUNE 4 1969 J. LEON WHITE PANOLA
 date well completed firm name county well located

LANDOWNER: LEIGHTY HARRIS
 Como, Miss.
 Rt. 2
 (mailing address)

description of formations encountered	from	to
Top Soil	0	18
MIXED SAND & CLAY	18	86
GRAVEL	86	110
MED. COARSE SAND	110	125

WELL LOCATION:
 sec. 17 T. 17 N. R. 7 E.
 5 miles S-W of Como
 (distance) (direction) (nearest town)

WELL PURPOSE: HOME
 (home, irrigation, municipal, industrial)

- WELL COMPLETION DATA:
- (1) diameter (inches) 4"
 - (2) total depth (feet) 125'
 - (3) static water level (feet) 92' (below) above top of ground.
 - (4) casing PLASTIC, 170' (material) (depth)
 4" (size) if telescope see back.
 - (5) screen 5' (length), 125' (depth to top)
 4" (size), PLASTIC (material)
 - (6) pump 3/4 (HP), 10 (yield gpm)
 FLE. (type power)
 - (7) electric log No (yes or no)
 (organization running log)
 - (8) how well bottom plugged STRAINER

CODED


JUN 11 1969

MISS. BD. OF
 WATER COMM.

DRILLERS REMARKS:

If well telescopes please sketch and show depths.

GROUND LEVEL

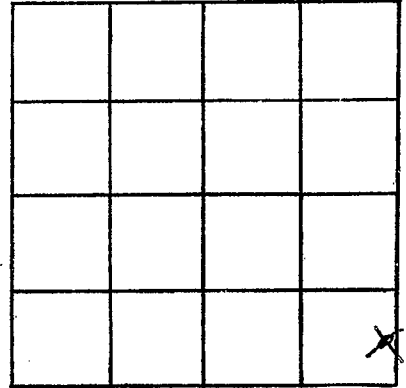

SECTION 17

Please indicate well location X.

ADDITIONAL INFORMATION

If more than one screen,
show locations of each on sketch.