

Panola
G17
11-3-69

MISSISSIPPI
BOARD OF WATER COMMISSIONERS
416 North State Street
Jackson, Mississippi 39201

CODED

WATER WELL DRILLERS LOG

19 PIPE Well CO. firm name PANOLA county well located

date well completed

LANDOWNER:
George S. Wright
Rt 2, Box 272
Camd, Miss.
(mailing address)

description of formations encountered	from	to
top soil + sand	0	20
sand (coarse) gravel	20	40
gravel	40	60
gravel	60	80
gravel + sand	80	100
sand	100	120
sand - clay (DR)	120	130

WELL LOCATION:
sec. 16 T 7 N R 7 E
4 miles NW of Sandis
(distance) (direction) (nearest town)

WELL PURPOSE: home
(home, irrigation, municipal, industrial)

WELL COMPLETION DATA:

(1) diameter (inches) 4"

(2) total depth (feet) 129'

(3) static water level (feet) _____ below above top of ground.

(4) casing PVC (material) 121' (depth)
4" (size) if telescope see back.

(5) screen 8 (length) 121' (depth to top)
4" (size) PVC + silica (material)

(6) pump 1/2 (HP) 12 (yield gpm)
Elec. (type power)

(7) electric log NO (yes or no)
✓

(organization running log)

(8) how well bottom plugged PVC cap

CODED


NOV 8 - 1969

DRILLERS REMARKS: rock 125'

MISS. BD. OF
WATER CONTROL

If well telescopes please sketch and show depths.

GROUND LEVEL

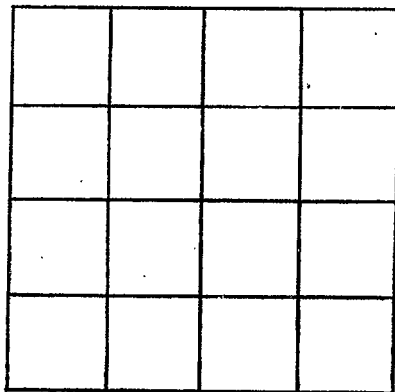

SECTION 16

Please indicate well location X.

ADDITIONAL INFORMATION

A series of horizontal lines for recording additional information.

If more than one screen, show locations of each on sketch.