

RTN for S + R 11/9/69  
Revised 12/22/69 OK JER

MISSISSIPPI  
BOARD OF WATER COMMISSIONERS  
416 North State Street  
Jackson, Mississippi 39201

CODED  
CODED  
**CODED**

WATER WELL DRILLERS LOG

Panola  
G 18  
10-69

OCT 24, 1969  
date well completed

WATSON Co.  
firm name

PANOLA  
county well located

LANDOWNER: DON BARTLETT  
COMO MISS.

description of formations encountered

	from	to
<u>SURFACE CLAY</u>	<u>0</u>	<u>29</u>

(mailing address)

<u>SAND &amp; GRAVEL</u>	<u>29</u>	<u>47</u>
--------------------------	-----------	-----------

WELL LOCATION:

sec. 6 T. 7 N. R. 7 E.  
4 miles EAST of COMO  
(distance) (direction) (nearest town)

<u>SAND</u>	<u>42</u>	<u>70</u>
-------------	-----------	-----------

<u>ROCK</u>	<u>70</u>	<u>72</u>
-------------	-----------	-----------

WELL PURPOSE: FARM  
(home, irrigation, municipal, industrial)

<u>CLAY</u>	<u>72</u>	<u>91</u>
-------------	-----------	-----------

WELL COMPLETION DATA:

- (1) diameter (inches) 4"
- (2) total depth (feet) 168
- (3) static water level (feet) 69' below top of ground.
- (4) casing STEEL, 158'  
(material) (depth)

<u>FINE SAND</u>	<u>91</u>	<u>152</u>
------------------	-----------	------------

<u>MED. SAND</u>	<u>152</u>	<u>168</u>
------------------	------------	------------

\_\_\_\_\_ if telescope see back.  
(size)

- (5) screen 10' , 158'  
(length) (depth to top)

**CODED**

4" NOMINAL, STAINLESS  
(size) (material)

- (6) pump 5 72 GPM  
(HP) (yield gpm)

ELEC.  
(type power)

- (7) electric log No  
(yes or no)

\_\_\_\_\_ (organization running log)

NOV 4 1969


- (8) how well bottom plugged  
C.I. PLUG

MISS. BD. OF  
WATER COMMISSIONERS

DRILLERS REMARKS:

If well telescopes please sketch and show depths.

GROUND LEVEL

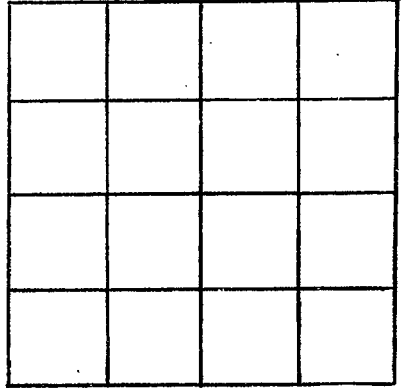

SECTION \_\_\_\_\_

Please indicate well location X.

ADDITIONAL INFORMATION

If more than one screen, show locations of each on sketch.