

PANOLA
G 19
10-26-70

MISSISSIPPI
BOARD OF WATER COMMISSIONERS
416 North State Street
Jackson, Mississippi 39201

CODED

WATER WELL DRILLERS LOG

10-26 1970 James A. Lipe Panola
date well completed firm name county well located

LANDOWNER: Charles Reed
Sardis Miss.

| description of fomations encountered | from | to |
|--------------------------------------|------|-----|
| Clay | 0 | 20 |
| | 20 | 40 |
| Sand | 40 | 60 |
| Sand and gravel | 60 | 80 |
| | 80 | 100 |
| Sand | 100 | 120 |
| Clay | 120 | 140 |
| | 140 | 160 |
| | 160 | 180 |
| Sand | 180 | 200 |
| | 200 | 211 |

(mailing address)

WELL LOCATION:
sec 29 T 7 N R 7 E
3 miles West of Sardis
(distance) (direction) (nearest town)

WELL PURPOSE: HOME
(home, irrigation, municipal, industrial)

WELL COMPLETION DATA:

- (1) diameter (inches) 4
- (2) total depth (feet) 211
- (3) static water level (feet) 100 below top of ground.
- (4) casing PVC 201 (material) (depth)
(size) if telescope see back.
- (5) screen 10 201 (length) (depth to top)
4 PVC (size) (material)
- (6) pump 3/4 15 (HP) (yield gpm)
Elec (type power)
- (7) electric log No (yes or no)

CODED

(organization running log)

DEC 3 1970


(8) how well bottom plugged PVC Plug

MISS. BD. OF
WATER COMM.

DRILLERS REMARKS:

If well telescopes please sketch and show depths.

GROUND LEVEL

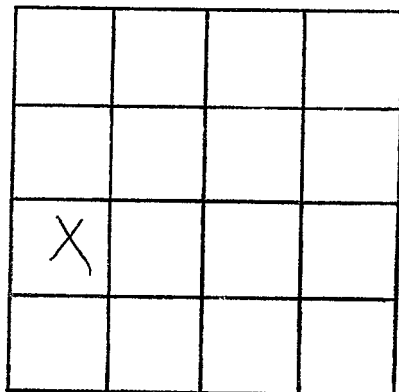

SECTION 29

Please indicate well location X.

ADDITIONAL INFORMATION

If more than one screen,
show locations of each on sketch.