

MISSISSIPPI  
BOARD OF WATER COMMISSIONERS  
416 North State Street  
Jackson, Mississippi 39201

**CODED**

WATER WELL DRILLERS LOG

PANOLA  
G26  
6-15-73

JUNE 15 1973 J. LEON WHITE PANOLA  
date well completed firm name county well located

LANDOWNER: J. L. WHITE  
SARDIS, MISS.  
Rt. 2 Box 118  
(mailing address)

description of formations encountered	from	to
TOP SOIL	0	18
MIXED GRAVEL & SAND	18	85
MED FINE WHITE SAND	85	125

WELL LOCATION:  
sec. 31 T. 7 N R. 7 E  
7 miles S-W of SARDIS  
(distance) (direction) (nearest town)

**CODED**

WELL PURPOSE: HOME  
(home, irrigation, municipal, industrial)


- WELL COMPLETION DATA:
- (1) diameter (inches) 4"
  - (2) total depth (feet) 125'
  - (3) static water level (feet) 93' below top of ground.
  - (4) casing PLASTIC, 115'  
(material) (depth)  
4" (size) if telescope see back.
  - (5) screen 10' 125'  
(length) (depth to top)  
2" SAND PACK PLASTIC  
(size) (material)
  - (6) pump 3/4 10-15  
(HP) (yield gpm)  
F.L.E.  
(type power)
  - (7) electric log NO  
(yes or no)  
  
(organization running log)
  - (8) how well bottom plugged STRAINER

DRILLERS REMARKS:

JUN 25 1973

If well telescopes please sketch and show depths.

GROUND LEVEL

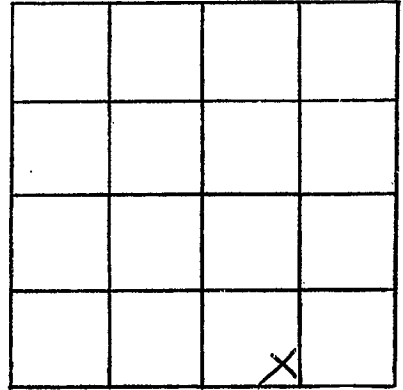

SECTION 31

Please indicate well location X.

ADDITIONAL INFORMATION

If more than one screen,  
show locations of each on sketch.