

MISSISSIPPI
BOARD OF WATER COMMISSIONERS
416 North State Street
Jackson, Mississippi 39201

CODED

PANOLA
G 27
6-3-73

WATER WELL DRILLERS LOG

JUNE 3 19 73 J. LEON WHITE PANOLA
date well completed firm name county well located

LANDOWNER: Will Titos

description of formations encountered

from to

Pomona, Miss.

TOP SOIL

0 15

Rt. 2

COARSE MIXED SAND

15 90

(mailing address)

LIGHT GRAVEL

MED. COARSE WHITE SAND

90 120

WELL LOCATION:

sec. 16 T. 7 N. R. 7 E.
5 miles SW of Pomona
(distance) (direction) (nearest town)

WELL PURPOSE: HOME
(home, irrigation, municipal, industrial)

WELL COMPLETION DATA:

- (1) diameter (inches) 4"
- (2) total depth (feet) 120'
- (3) static water level (feet) 60 ^{below} _{above} top of ground.
- (4) casing PLASTIC, 110'
(material) (depth)
4"
(size) If telescope see back.
- (5) screen 10', 120
(length) (depth to top)
2", SANDPACK PLASTIC
(size) (material)
- (6) pump 1/2 8-10
(HP) (yield gpm)
E.L.F.
(type power)
- (7) electric log NO
(yes or no)

(organization running log)
- (8) how well bottom plugged STRAINER


CODED

DRILLERS REMARKS:

JUN 25 1973

If well telescopes please sketch and show depths.

GROUND LEVEL

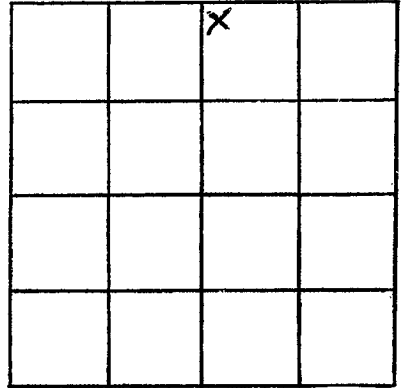

SECTION 16

Please indicate well location X.

ADDITIONAL INFORMATION

If more than one screen,
show locations of each on sketch.