

PANOLA
G 31
4-9-74

MISSISSIPPI
BOARD OF WATER COMMISSIONERS
416 North State Street
Jackson, Mississippi 39201

CODED

WATER WELL DRILLERS LOG

4-9 date well completed 1974 Lipe well Co. firm name Panola county well located

LANDOWNER:
David Trammell
Sardis, Miss.
(mailing address)

description of formations encountered	from	to
Top soil	0	20
red sand	20	40
gravel	40	60
White clay	60	80
sand	80	118

WELL LOCATION:
sec. 31 T. 7 N. R. 6 E
3 miles S. E. of Sardis
(distance) (direction) (nearest town)

WELL PURPOSE:
(home) irrigation, municipal, industrial

- WELL COMPLETION DATA:
- (1) diameter (inches) 4
 - (2) total depth (feet) 118
 - (3) static water level (feet) 80 below top of ground.
 - (4) casing PVC 108 (material) (depth)
4 (size) if telescope see back.
 - (5) screen 10 108 (length) (depth to top)
4 PVC (size) (material)
 - (6) pump 3/4 10 (HP) (yield gpm)
elec. (type power)
 - (7) electric log NO (yes or no)
NO (organization running log)
 - (8) how well bottom plugged PVC plug


CODED

DRILLERS REMARKS:

MISS. BD. OF WATER COMMISSIONERS

If well telescopes please sketch and show depths.

GROUND LEVEL

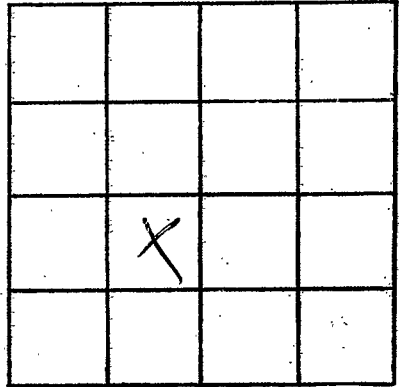

SECTION 37

Please indicate well location X.

ADDITIONAL INFORMATION

If more than one screen,
show locations of each on sketch.