

PANOLA

G 32

4-16-74

MISSISSIPPI BOARD OF WATER COMMISSIONERS  
416 North State Street  
Jackson, Mississippi 39201

CODED

WATER WELL DRILLERS LOG

4-16  
date well completed

74 Life Well Co.  
firm name

Panola  
county well located

LANDOWNER:  
Buford S. Henson  
Co Mo Miss.  
(mailing address)

description of formations encountered	from	to
Top Soil	0	20
CLAY	20	40
SAND	40	60
GRAVEL	60	80
LI	80	100
LI	100	120
SAND	120	140
White SAND	140	180

WELL LOCATION:  
Sec 10 T 2 N R 2 E  
3 miles north of Sardis  
(distance) (direction) (nearest town)

WELL PURPOSE:  
(home, irrigation, municipal, industrial)

- WELL COMPLETION DATA:
- (1) diameter (inches) 4
  - (2) total depth (feet) 180
  - (3) static water level (feet) 100 below top of ground.
  - (4) casing PVC 170 (material) (depth)
  - 4 (size) if telescope see back.
  - (5) screen 10 170 (length) (depth to top)
  - 4 PVC (size) (material)
  - (6) pump 3/4 10 (HP) (yield gpm)
  - elec. (type power)
  - (7) electric log NO (yes or no)
  - NO (organization running log)
  - (8) how well bottom plugged PVC plug


DRILLERS REMARKS:

CODED

MISS. Bd. of Water Comm.  
MAY 16 1974

If well telescopes please sketch and show depths.

GROUND LEVEL

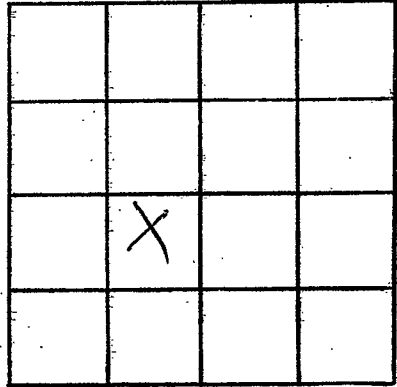

SECTION

10

Please indicate well location X.

ADDITIONAL INFORMATION

If more than one screen, show locations of each on sketch.