

PANOLA

LS 7001

3/22/78

MISSISSIPPI
 BOARD OF WATER COMMISSIONERS
 416 North State Street
 Jackson, Mississippi 39201

WATER WELL DRILLERS LOG

3-22 1978
date well completed

Harris Bros. Panola
firm name county well located

LANDOWNER: J. S. Taylor

Como

(mailing address)

WELL LOCATION:

sec. 6 T. 7 N. R. 7 E.
 (S) (W)
 2 miles W of Como
 (distance) (direction) (nearest town)

WELL PURPOSE: home
 (home, irrigation, municipal, industrial)

WELL COMPLETION DATA:

- (1) diameter (inches) 4
- (2) total depth (feet) 210
- (3) static water level (feet) 80 ^{below} top of ground.
- (4) casing Plastic, 196 (material) (depth)
 4" (size) if telescope see back.
- (5) screen 14, 196 (length) (depth to top)
 008, Plastic (size) (material)
- (6) pump 3/4, 10 (HP) (yield gpm)
 elec. (type power)
- (7) electric log no (yes or no)

(organization running log)

(8) how well bottom plugged solid

description of formations encountered

from to

top soil	0	20
red sand + clay	20	60
pea gravel + sand	60	110
clay + fine sand	110	190
coarse sand	190	210

RECEIVED


APR 26 1978

DRILLERS REMARKS:

MISS. BD. OF WATER COMMISSIONERS

If well telescopes please sketch and show depths.

GROUND LEVEL

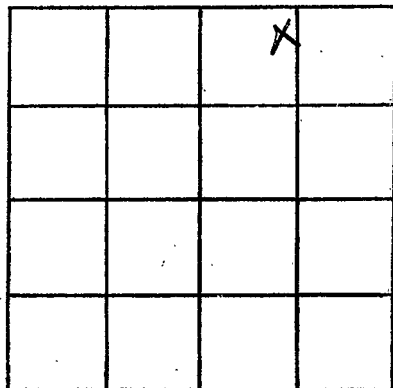

SECTION 6

Please indicate well location X.

ADDITIONAL INFORMATION

If more than one screen, show locations of each on sketch.