

PANOLA
 G 2003
 5-15-79

MISSISSIPPI
 BOARD OF WATER COMMISSIONERS
 416 North State Street
 Jackson, Mississippi 39201

WATER WELL DRILLERS LOG

5-15 19 79 Nicks Well Co Panola
 date well completed firm name county well located

LANDOWNER:
 Carrolan Small
 Rt. Camo Miss.
 (mailing address)

description of formations encountered	from	to
Red Clay	0	65
Sand & Gravel	65	125
Sand & Clay	125	170
White sand	140	172

WELL LOCATION:
 sec. 7 T. 7 N. R. 7 E.
 2 1/2 miles S of Camo
 (distance) (direction) (nearest town)

WELL PURPOSE: home
 (home, irrigation, municipal, industrial)

WELL COMPLETION DATA:
 (1) diameter (inches) 4 in
 (2) total depth (feet) 172
 (3) static water level (feet) 120 below top of ground.
 (4) casing P. Plastic 172 (material) (depth)
 (size) If telescope see back.
 (5) screen 4 7/8 165 (length) (depth to top)
 4 in Gravel (size) (material)
 (6) pump 1/2 10 (HP) (yield gpm)
 220 (type power)
 (7) electric log No (yes or no)
 (organization running log)

(8) how well bottom plugged Cap

DRILLERS REMARKS:


Miss. Board of Water Comm.

JUN 1 1979

RECEIVED

If well telescopes please sketch and show depths.

GROUND LEVEL

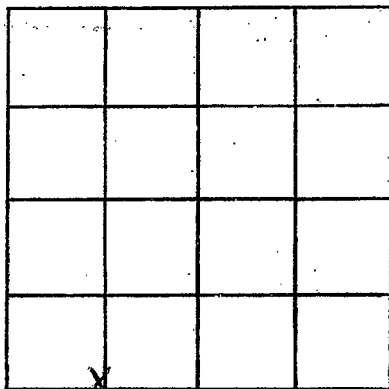

SECTION 7

Please indicate well location X.

ADDITIONAL INFORMATION

If more than one screen, show locations of each on sketch.