

MISSISSIPPI DEPARTMENT OF NATURAL RESOURCES

Bureau of Land and Water Resources

Southport Mall

P.O. Box 10631

Jackson, Mississippi 39209

WATER WELL DRILLERS LOG

PANOLA
G 2004
12/18/80
12/18/80

date well completed 19 12/18/80 firm name Lipe Well Drilling Co. Panola county well located Panola

LANDOWNER: Robert Carter
Como

description of formations encountered	from	to
CLAY	0	20
SAND / CLAY	20	40
ROCK SAND	40	60
SAND	60	80
SAND	80	100
SAND	100	120
	120	140

(mailing address)

WELL LOCATION:
sec. 5 T 7 N R 7 E
4 miles W of Como
(distance) (direction) (nearest town)

WELL PURPOSE:
(home, irrigation, municipal, industrial)

WELL COMPLETION DATA:


- (1) diameter (inches) 4
- (2) total depth (feet) 140
- (3) static water level (feet) 75 below above top of ground.
- (4) casing PVC, 152,
(material) (depth)
4
(size) if telescope see back.
- (5) screen 9,
(length) (depth to top)
(size) (material)
- (6) pump 3/4 10
(HP) (yield gpm)
(type power)
- (7) electric log (yes or no)
(organization running log)
- (8) how well bottom plugged cap

DRILLERS REMARKS:

DEPT. OF NATURAL RESOURCES
BUREAU OF LAND & WATER RESOURCES
MAR - 9 1981
RECEIVED

If well telescopes please sketch and show depths.

GROUND LEVEL

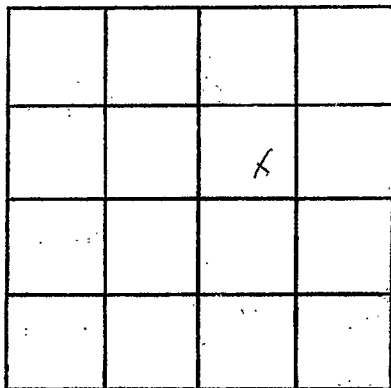

SECTION _____

Please indicate well location X.

ADDITIONAL INFORMATION

If more than one screen,
show locations of each on sketch.